

WATER SERVICE RECORD

1052

Name John Bullock Realty Const.

Service No. 181

Address 16 Garfield Street

Location

~~XXXXXX~~ ~~XXXXXX~~ ~~XXXXXX~~ New Service

Comm 11-9-59


Date	Material	Amount	Total	Date	Amount
8-17-59	Labor	1.95		8-13-59	Deposit 25.00
	10% O.H.	.20	2.15	11-9-59	Returned 16.26
	Owners Copper				8.74
1	3/4" C x 1/2 I.W.H. Stop & Waste		5.84		NON CHARGE
1	hr. Trucking @.75		.75		Labor 1.91
			8.74	26'	3/4" Copper tubing @.41 10.66
				1	3/4" C Curb Cock 4.64
				1	3/4" C Curb Cock 5.94
				1	Box & Rod 5.00
				1	1/2 Straight tailpiece .50
				1	1/2 Offset tailpiece .50
					29.15
				* Applied to DWCH # 128	3.28
				* " " " # 129	12.98

DATE _____

TOWN OF LEXINGTON — BOARD OF PUBLIC WORKS

WATER DIVISION

Sketch of Service Here

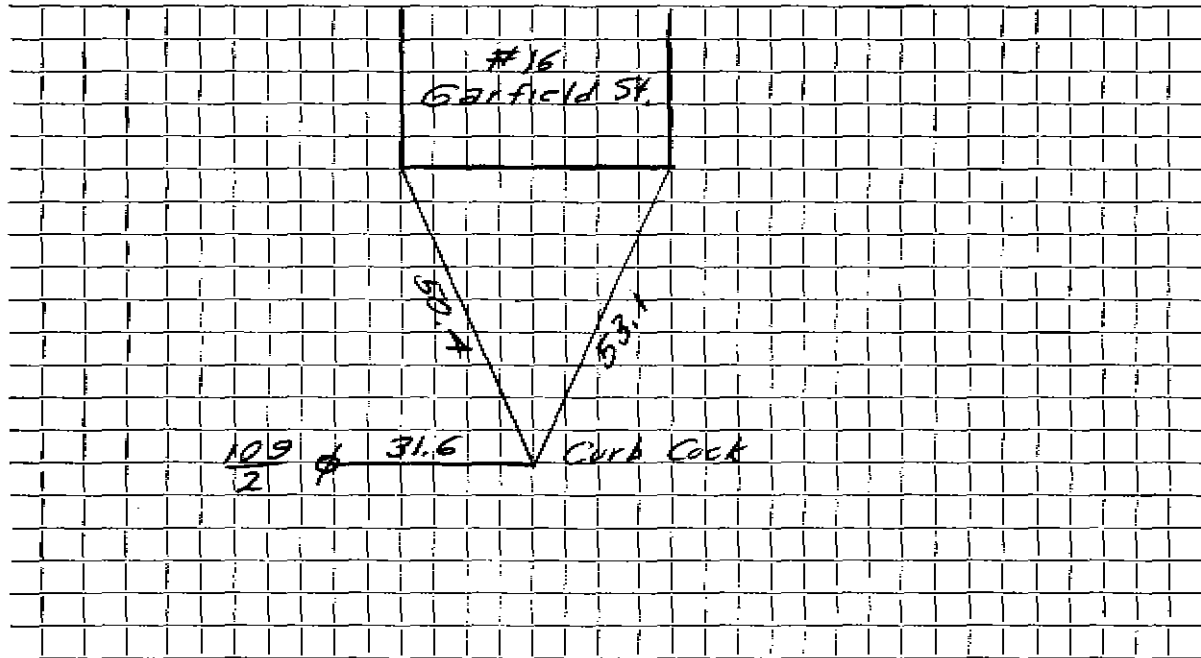

Connection made in Street. Work completed

Remarks:

.....

.....