

Name Alfred Braccini  
 Address 19 Garfield St.,

Service No. # 999  
 # 1573

Location same

Kind of Pipe Size Size of Main

~~Repair~~—Renewal—~~New Service~~

Location

Date	Material	Amount	Total	Date	Amount
1937					
4/21/	4 hrs. @ 60¢	2 40	2 40	<i>April 29 '37 deposited</i>	40 00
<del>4/21/</del>	80' 3/4" Cop. Tub. @ 20¢		16 00		
	1 3/4" S. & W.		3 00		
	1 3/4" Cop. Union.		35		
	2 hrs. Trucking @ 75¢		1 50		
			<u>23 25</u>		
	No Trench repairs				
	Say: 80' @ 50¢		40 00		
	Labor				
	<i>w/Marked</i>				

Hadley Press, Inc., Lexington

DATE \_\_\_\_\_

# TOWN OF LEXINGTON—BOARD OF PUBLIC WORKS

## WATER DIVISION

The undersigned applies for a supply of water at No. \_\_\_\_\_ St. and hereby agrees to comply with the rules and regulations as now, or at any future time, established by the Board of Selectmen.

Am't. of Estimate \$ \_\_\_\_\_


Owner \_\_\_\_\_

Am't. Paid \$ \_\_\_\_\_

Address \_\_\_\_\_

Builder \_\_\_\_\_

Sketch of Service Here

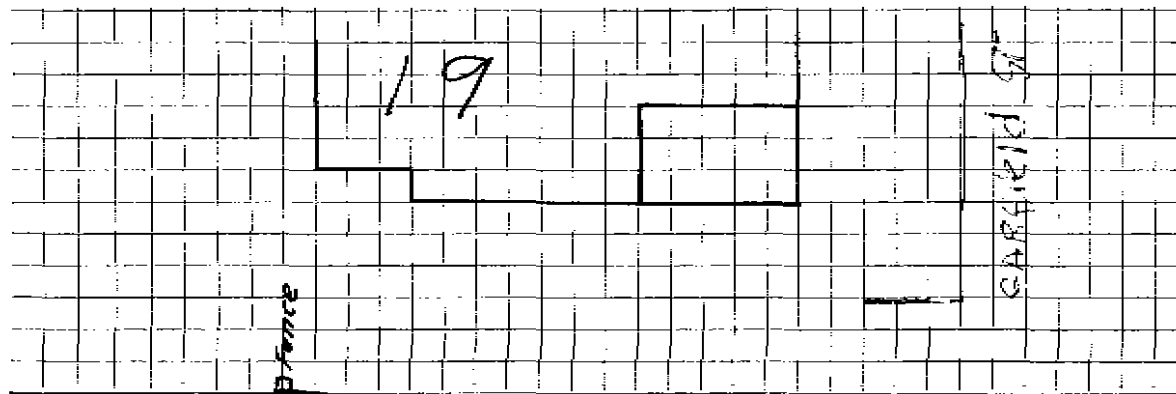

Connection made in \_\_\_\_\_ S.B. 48.9 Street. Work completed \_\_\_\_\_ 19

Remarks:

WARD ST

41.8

