Name

WATER SERVICE RECORD

Service No.

Address 22 Garfield Street Feeds No-20
Location


11. see herry — Treate ut the state of the s							
Date	Material	Amount	Total	Date		Amou	ınt
1935	40 314 Copper 314 Stope waste						
	3/4 Stopewaste	; +	 		<u> </u>		
							!
·		<u> </u>		_#	NON CHARGE	ļ 	
 		 	-\\-\-\-\-\-\-\-\-\-\-\-\-\-\-\-\-\-\-	_ 9 -1- 60	Labor	50	97 -
	<u> </u>	 	<u> </u>	10'	3/1 Gopper tubing	@.112 l	20
\ 		<u> </u>	 		3/4" C Corp Cock);•	91
		· 	<u> </u>	_	3/h" C Curb Cock	5	28
-		<u> </u>	<u> </u>	1	Box & Rod	1.0	90
	 	┆ ╎ —————	<u> </u>	1 2	hrs. Pippin Shovel	@i/50_94	مدا
		<u> </u>	; - 		hr. Trucking 0.75	 	<u>75 </u>
		 	·			80.	11
		! +			\ 	\ <u>.</u>	
			- -	_	<u> </u>	<u> </u>	
	 - 	 	<u> </u>	 	 	 	:
		<u> </u>	<u> </u>			! }	
		<u> </u>	'] - 				
		<u> </u>			 	<u> </u>	
<u>1</u>	Ĭ	1 [لق ا	LL l.	I	L .	l_

DAT	E	 	 	

TOWN OF LEXINGTON - BOARD OF PUBLIC WORKS

WATER DIVISION

Sketch of Service Here

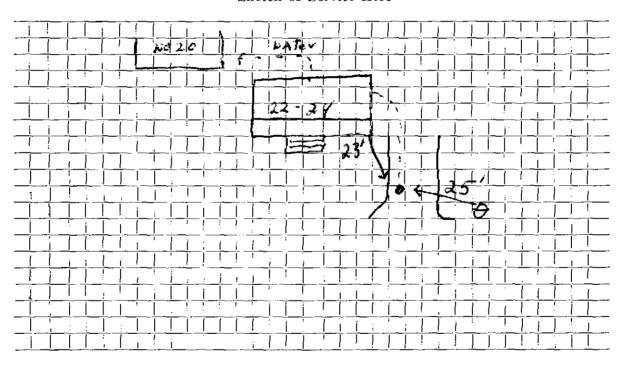

Connection made in	Street.	Work completed	
Remarks:			