

# 6137

## WATER SERVICE RECORD

Service No. 297

Name Jerome Garrity

Address 30 Garfield Street

Location

# 668

Reported by New Service


Conn. 12-19-55

Date	Material	Amount	Total	Date	Amount
9/23/55	Labor	1 85		8-29-55	Deposited
	10% overhead	.19	2 04	12-19-55	Refunded
	55' - 3/4" copper tubing @ .56		30 80		<u>NON CHARGE</u>
	1 - 3/4" O x $\frac{1}{4}$ I.W.H. stop & waste	4 00	9/28/55 Labor		1 85
	2 Hrs. Littlefield shovel @ 7.50	15 00	10' - 3/4" copper Tubing @ .56		5 60
	1 hr. trucking		75	1 - 3/4" O. corp-cock	4 33
			52 59	1 - 3/4" O. curb-cock	4 67
				1 box and rod	3 90
				1 - $\frac{1}{2}$ offset tail pc.	50
				1 - $\frac{1}{2}$ straight tail pc.	50
				1 hr. trucking	75
					22 10

DATE \_\_\_\_\_

TOWN OF LEXINGTON — BOARD OF PUBLIC WORKS  
WATER DIVISION

Sketch of Service Here

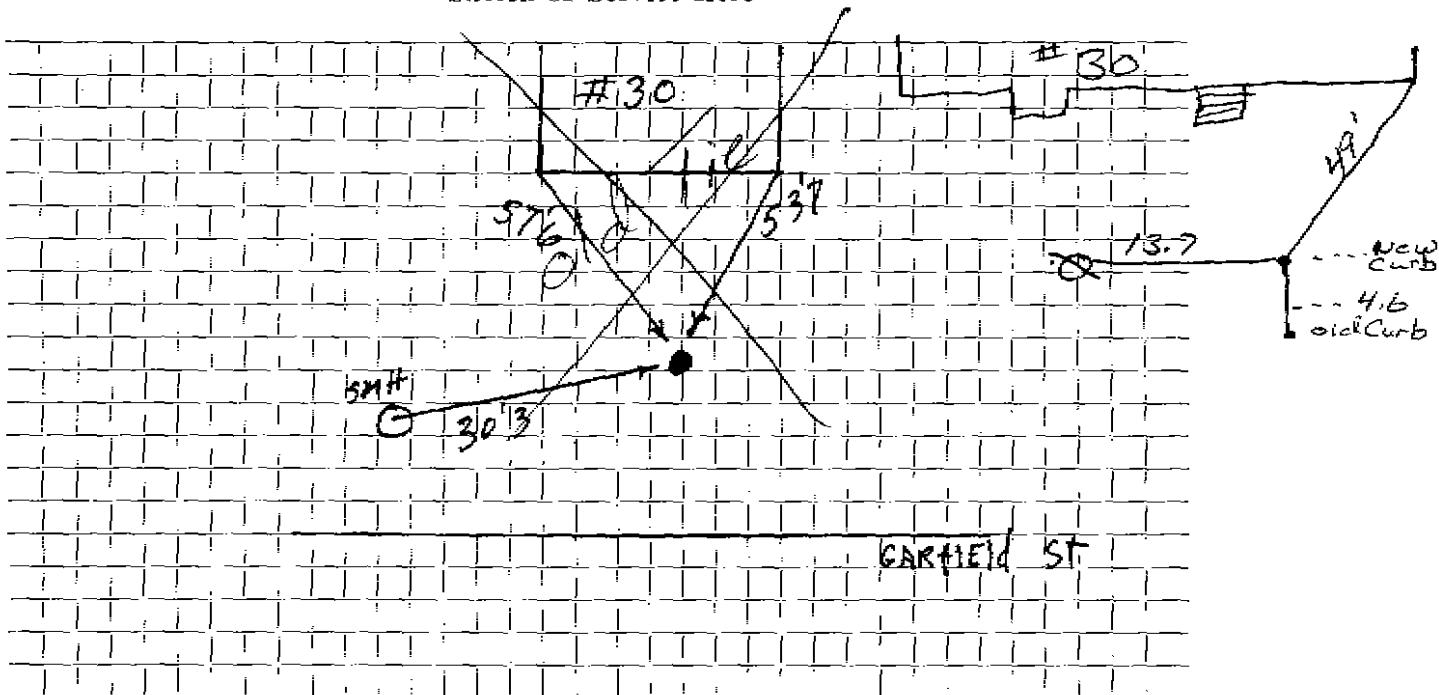

Connection made in ..... Street. Work completed .....

Remarks: .....