

Name Harold Johnson  
 Address 31 Garfield Street  
 Lexington, Mass.

Service No.

233  
 # 541

Location

Kind of Pipe

Size

Size of Main

~~Repair or Renewal~~—New Service

Location

Date	Material	Amount	Total	Date	Amount
Oct. 11, '48	Labor	2 20	2 20	Oct. 5, '48	45 00
	10% Overhead		22		11 67
	51'-3/4" Copper Tubing @ .255	13 01	31 15		83 88
	1-3/4" C x 1/2" I.W.H. S&W		31 15		
	2 hrs. Littlefield Shovel	14 00	14 00	Oct. 11, '48	2 20
	1 hr. Trucking		75	10'-3/4" Copper Tubing @ .255	2 55
			33 33	1-3/4" C. Corp-cock	3 00
				1-3/4" C x 3/4" C. curb-cock	3 68
				1-Box & Rod	3 55
				1 hr. Littlefield Shovel	7 00
				1-1/2" Offset Tail Piece	30
				1-1/2" Straight Tail Piece	30
				1 hr. Trucking	75
	Labor				23 33

*Oct. 5, '48 Deposited  
 Littlefield Shovel  
 Non charge*

TOWN OF LEXINGTON – BOARD OF PUBLIC WORKS  
**WATER DIVISION**

The undersigned applies for a supply of water at No..... St. and hereby agrees to comply with the rules and regulations as now, or at any future time, established by the Board of Selectmen.

Am't of Estimate \$.....


Owner .....

Am't Paid \$.....

Address .....

Builder .....

Sketch of Service Here

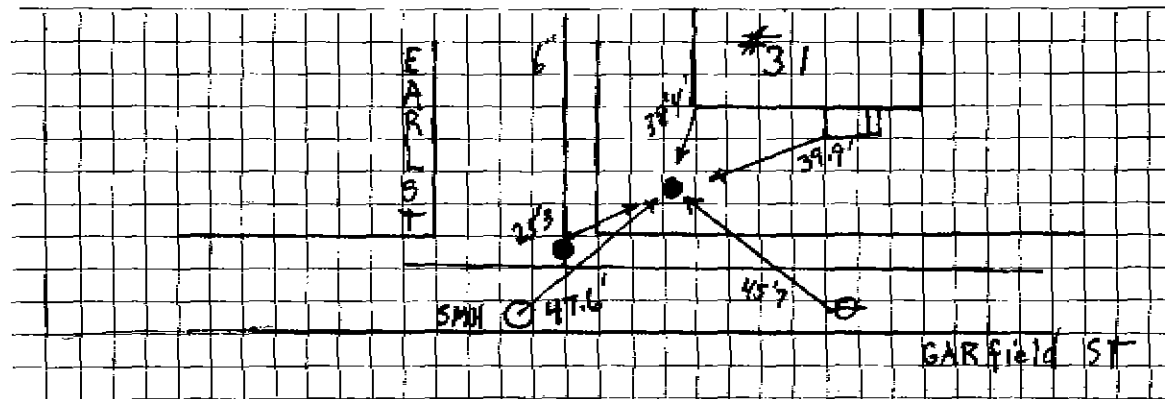

Connection made in ..... Street.

Work completed .....19

Remarks: