

WATER SERVICE RECORD

Name Bernard Foster

Service No. 43

Address 36 Garfield Street

Location Lexington, MA 02173

~~Repair/Reconnect~~ New Service D. G. Constr. Co., Inc. --Permit #3194--W.O. #5913


FEB 13 1978

Date	Material	Amount	Total	Date	Amount	
11-25-77	Labor	36 38		11-21-77	Deposit	500 00
	10% O.H.	3 63	40 01	1-13-77	Retard	85 16
	18' - 1" Copper @ 1.08		19 44			214 84
	1 - 1" Corporation		16 69			
	1 - 1" Curb		20 54			
	1 Box 7 Rod		13 41			
	½ Hr. Trucking		1 50			
	½ Hr. Backhoe		3 25			
			114 84			
11-25-77	42'-1" COPPER					

DATE _____

TOWN OF LEXINGTON — BOARD OF PUBLIC WORKS
WATER DIVISION

Sketch of Service Here

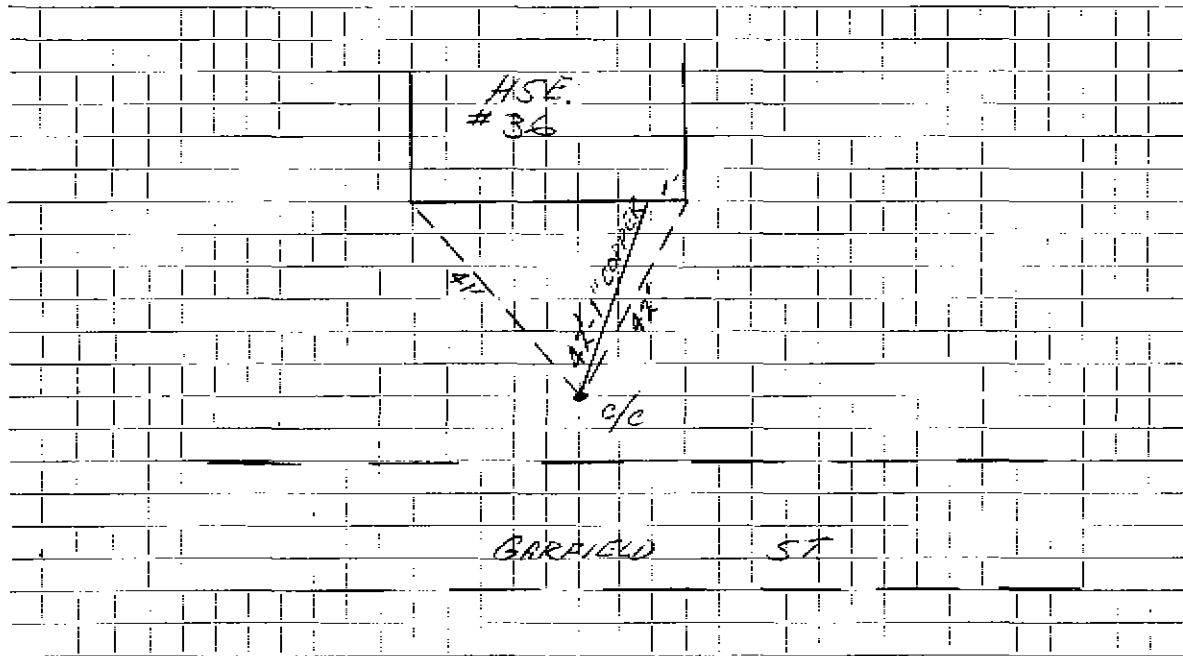

Connection made in Street. Work completed

Remarks:
.....
.....