

WATER SERVICE RECORD

Name Suprokash Sarker

Service No.

13

Address 40 Garfield St.

Location

AUG 8 1977

~~Repair—Renewal—New Service~~


Date	Material	Amount	Total	Date	Amount
6/30/77	labor	58. 12		4/21/77	Deposit 300. 00
	10%OH	5. 81	63. 93	8/8/77	Refund 179. 23
36'	3/4 copper @ .55		23. 40		120. 77
1	3/4 Wheel Handle		15. 98		
1	1/2 X 3/4 Brass Bushing		1. 46		
1	hrs. trucking		3. 00		
2	hrs. town shovel @ 6.50		13. 00		
			120. 77		

DATE _____

TOWN OF LEXINGTON — BOARD OF PUBLIC WORKS

WATER DIVISION

Sketch of Service Here

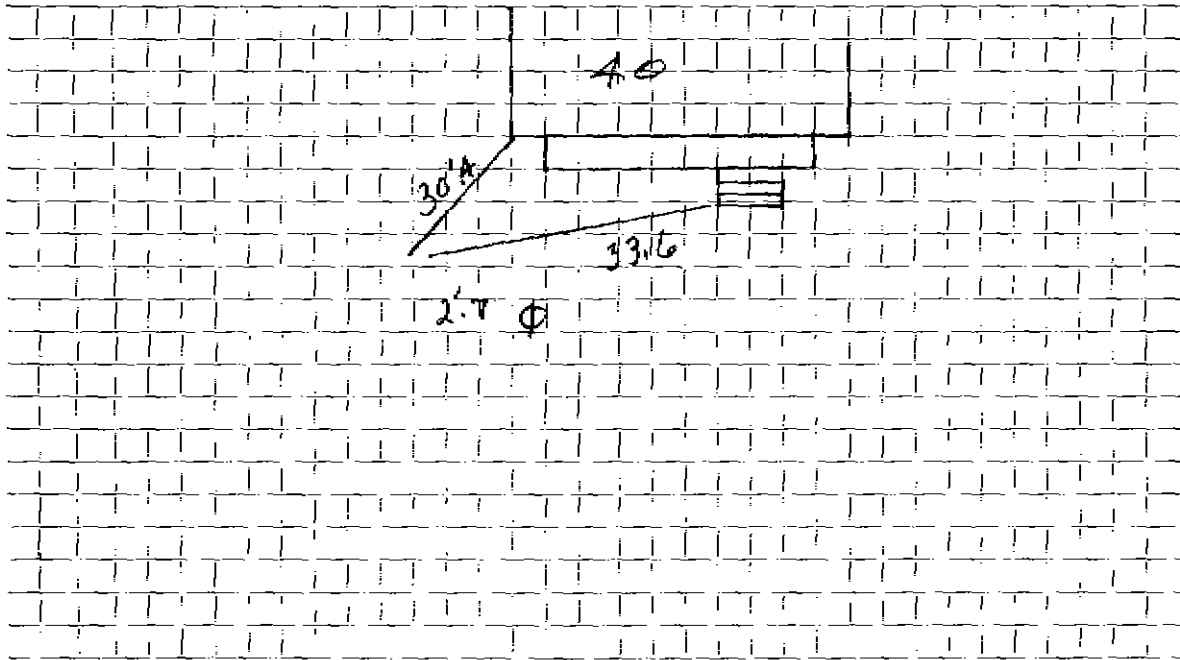

Connection made in Street, Work completed

Remarks:
.....
.....