

## WATER SERVICE RECORD

Name J.B.L. Construction Company

Service No. 17

Address 42 Garfield St.

Location

~~Repair~~ ~~Renewal~~ New Service WO #3300 Farsaras and Sons Heating and Plumbing


Date	Material	Amount	Total	Date	Amount
5/2/75	labor	20. 28		5/1/75	Deposit 200. 00
	10%OR	2. 03	22. 31	8/16/75	Refund 216. 48
13'	3/4" copper tubing @ 1.01		13. 13		83. 32
1	3/4" corp.		11. 58		
1	3/4" curb cock		14. 40		
1	box and rod		15. 40		
1hr.	back hoe		6. 50		
			83. 32		

DATE \_\_\_\_\_

TOWN OF LEXINGTON — BOARD OF PUBLIC WORKS

**WATER DIVISION**

Sketch of Service Here

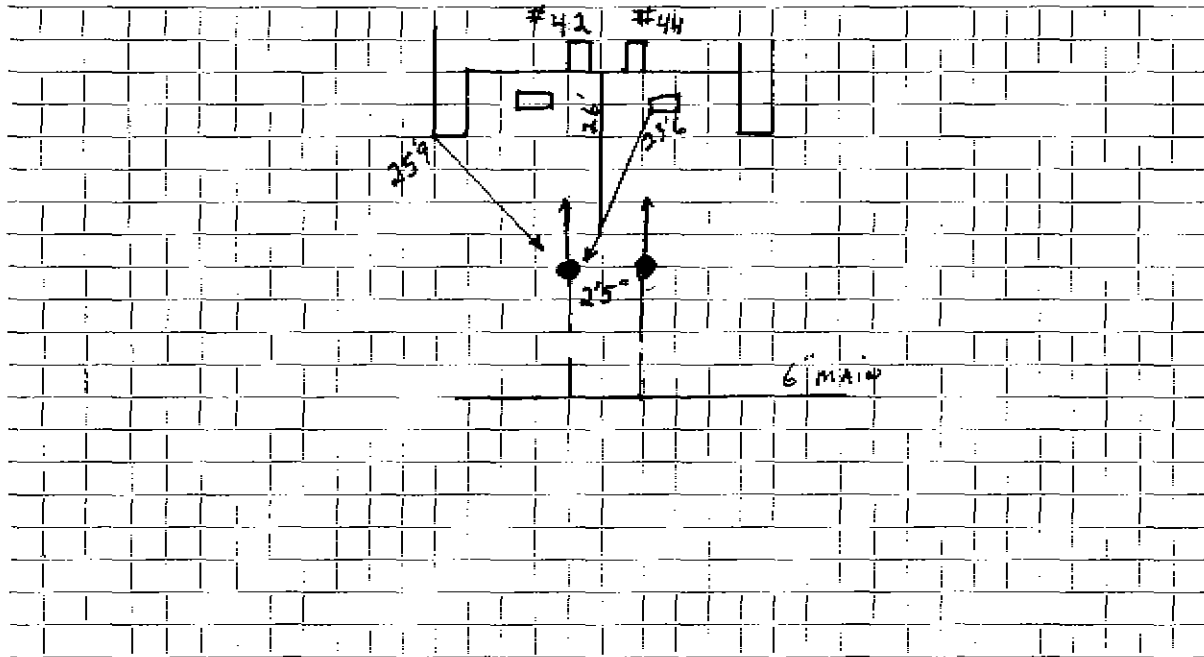


Connection made in ..... Street. Work completed .....

Remarks: .....

.....

.....

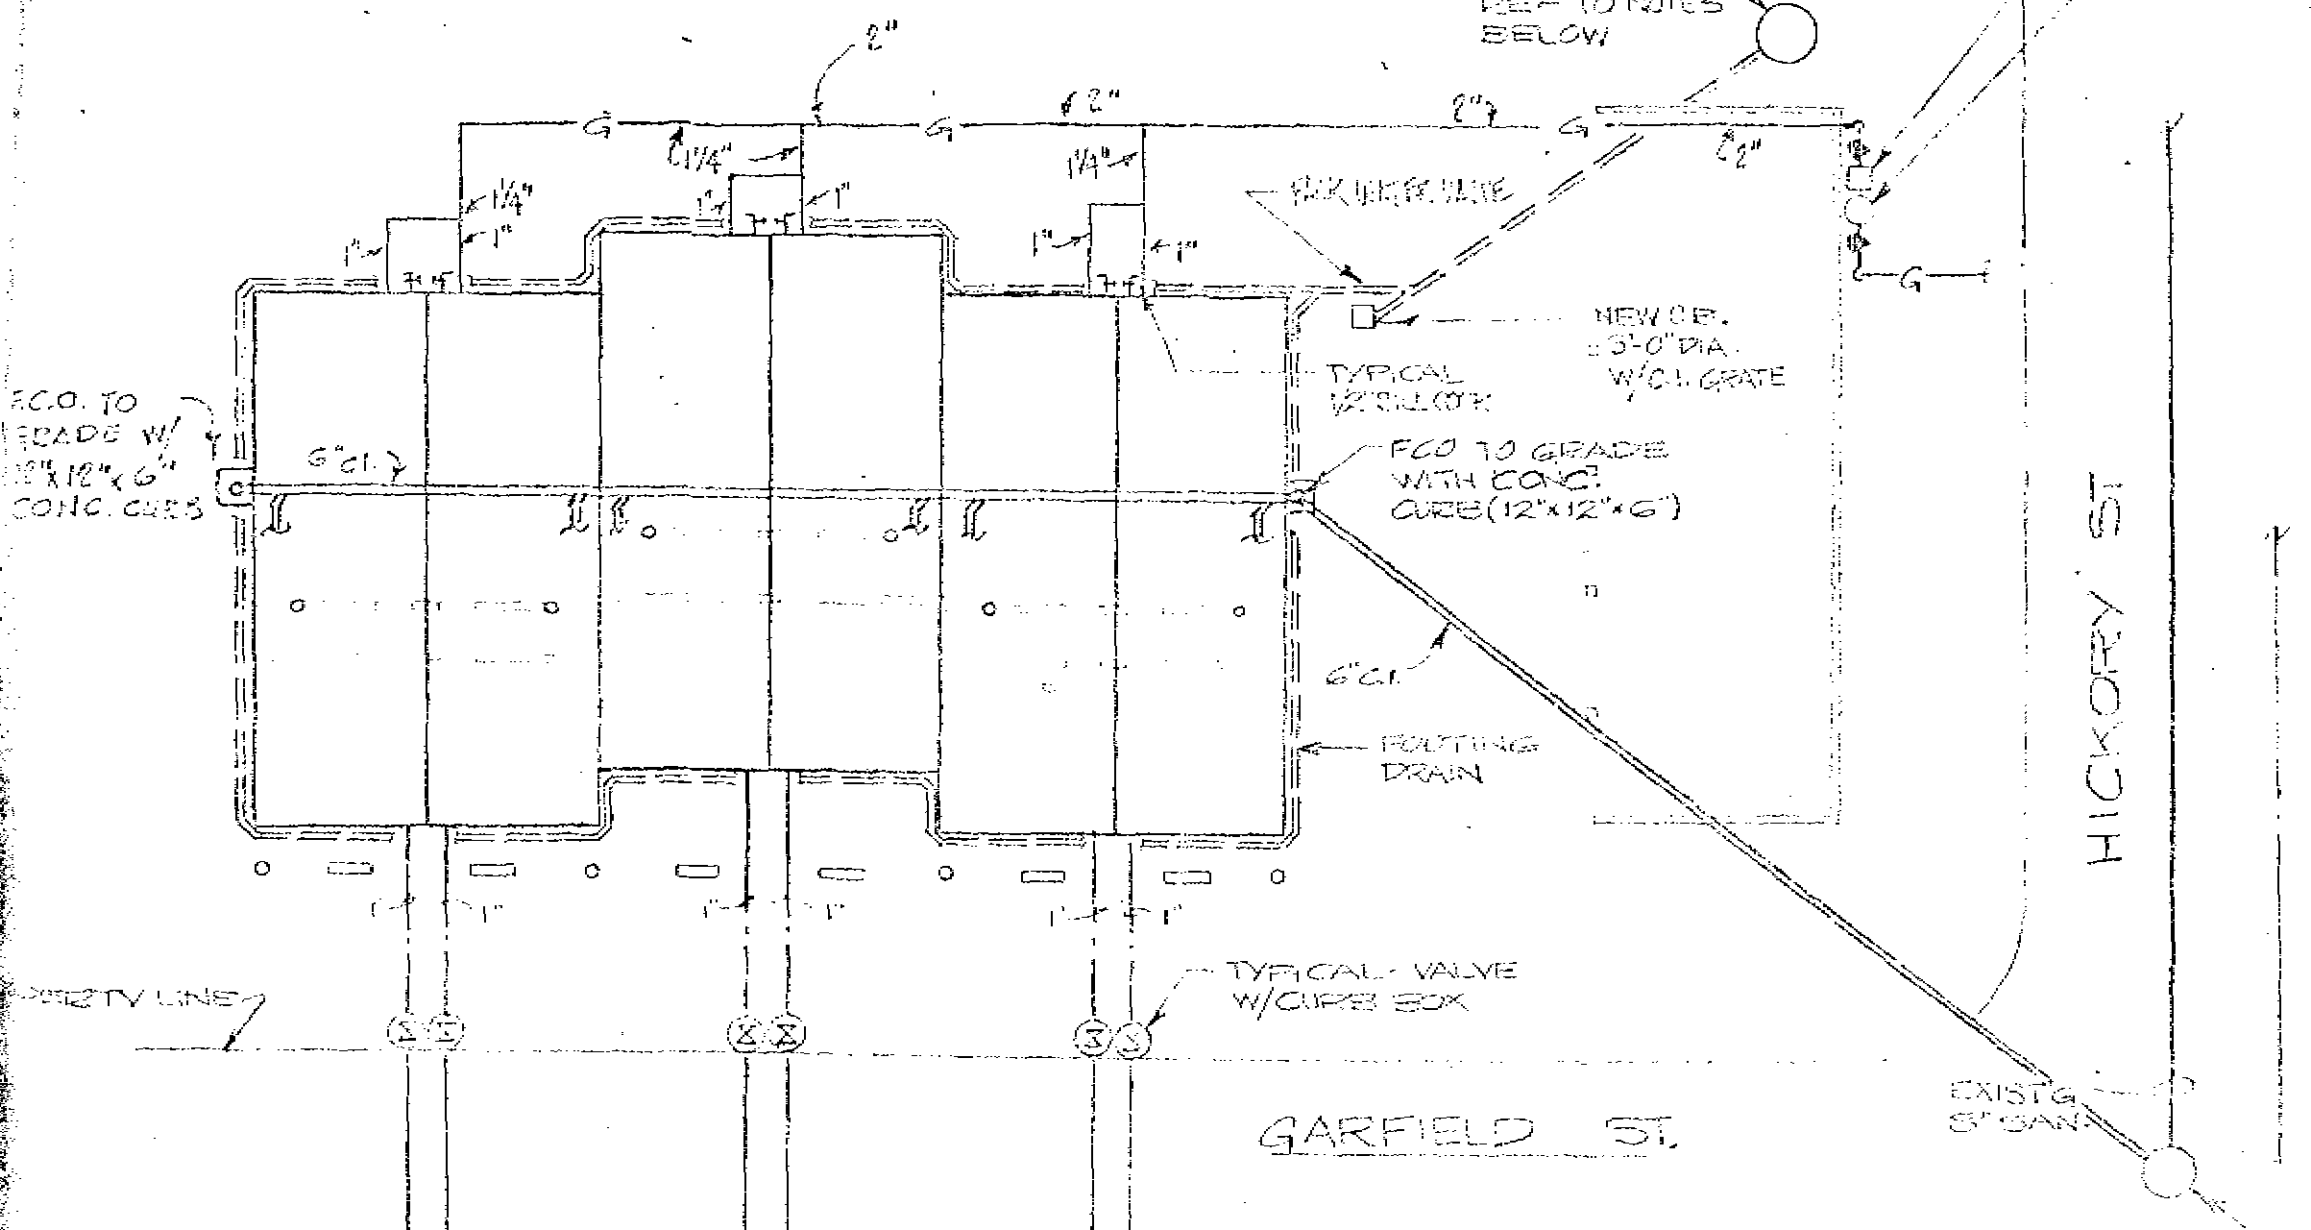

FCO TO GRADE W/ 12"X12"X6" CONC. CURB

REF TO NOTES BELOW

UTILITY LINE

GARFIELD ST

HICKORY ST

EXISTG 6" SAN

EXISTING 6" WATER MAIN PRESSURE 80-90 PSI

SERVICE MAINS INSTALLED BY TOWN OF LEANING TON TO PROPERTY FROM PROPERTY LINE TO INCLUDE WORK TO BE DONE BY A CONTRACTOR TOWN OF LEANING TON, MASS. IS FURNISHED BY TOWN INSTALLED BY PLUMBERS

**PARTIAL SITE PLAN**  
N.T.E.

**NOTES:**  
FOOT INSIDE DIA. DRY WELL W/ BLOCK FILLED WITH CRUSHED G WELL TO FILL 4 FOOT DEEPENED TO OF FOOTING DRAIN. COVER TO OF 15 LB PER PAPER.