

WATER SERVICE RECORD

Name J.B.L. Construction Company

Service No.

18

Address 44 Garfield Street

Location

~~Repair-Renewal~~ New Service WO #3301 Farsaras and Sons Plumbing and Heating #2630


Date	Material	Amount	Total	Date	Amount
5/2/75	labor	20. 28		5-1-75	300. 00
	10%OH	2. 03	22. 31	8-16-76	216. 68
	13' 3/4" copper tubing @	1.01	13. 13		83. 32
	1 3/4" cork		11. 58		
	1 3/4" curb cock		14. 40		
	1hr. backhoe		6. 50		
			83. 32		

DATE _____

TOWN OF LEXINGTON — BOARD OF PUBLIC WORKS

WATER DIVISION

Sketch of Service Here

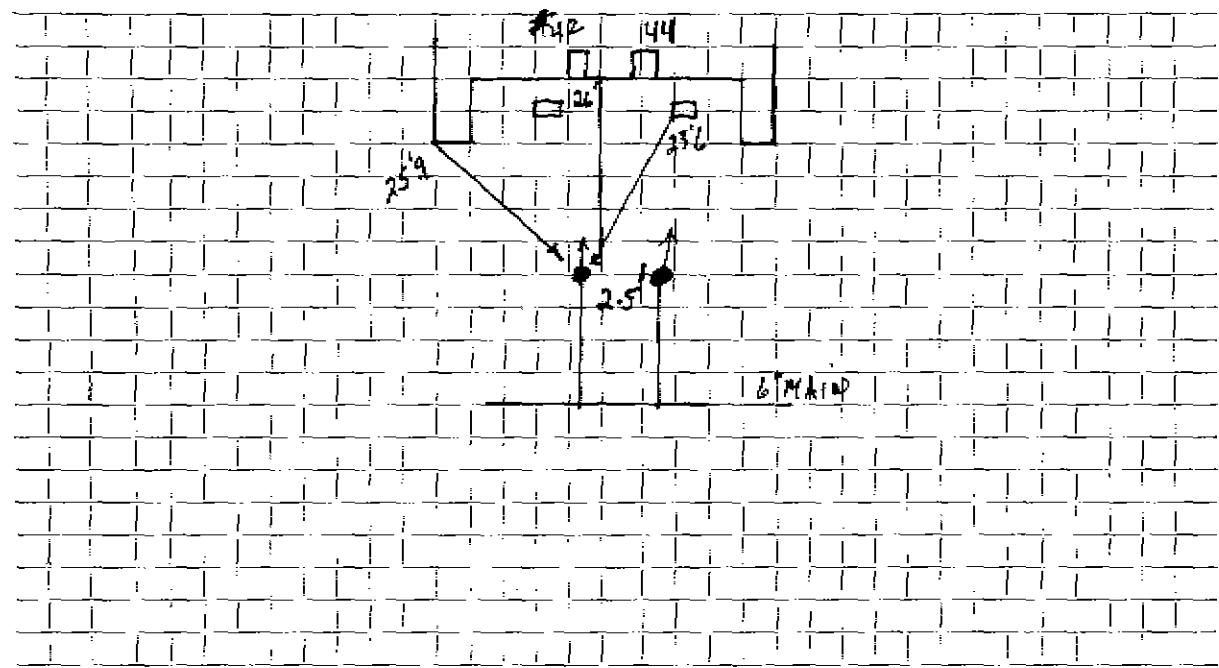

Connection made in Street. Work completed

Remarks:
.....
.....