

WATER SERVICE RECORD

Name J.B.L. Construction Company

Service No. 21

Address 50 Garfield St.

Location

~~Repair - Renewal~~ New Service NO #3304 Farsaras and Sons Heating and Plumbing #2633


Date	Material	Amount	Total	Date	Amount
5/2/76	labor	20. 28		5-1-76	Deposit 300. 00
	10% OH	2. 03	22. 31	8-16-76	Refund 216. 68
	13' 3/4" copper tubing @ 1.01		13. 13		83. 32
	1 3/4" corp		11. 58		
	1 3/4" curb cock		14. 40		
	1 box and rod		15. 40		
	1 hr. back hoe		6. 50		
			83. 32		

DATE _____

TOWN OF LEXINGTON — BOARD OF PUBLIC WORKS

WATER DIVISION

Sketch of Service Here

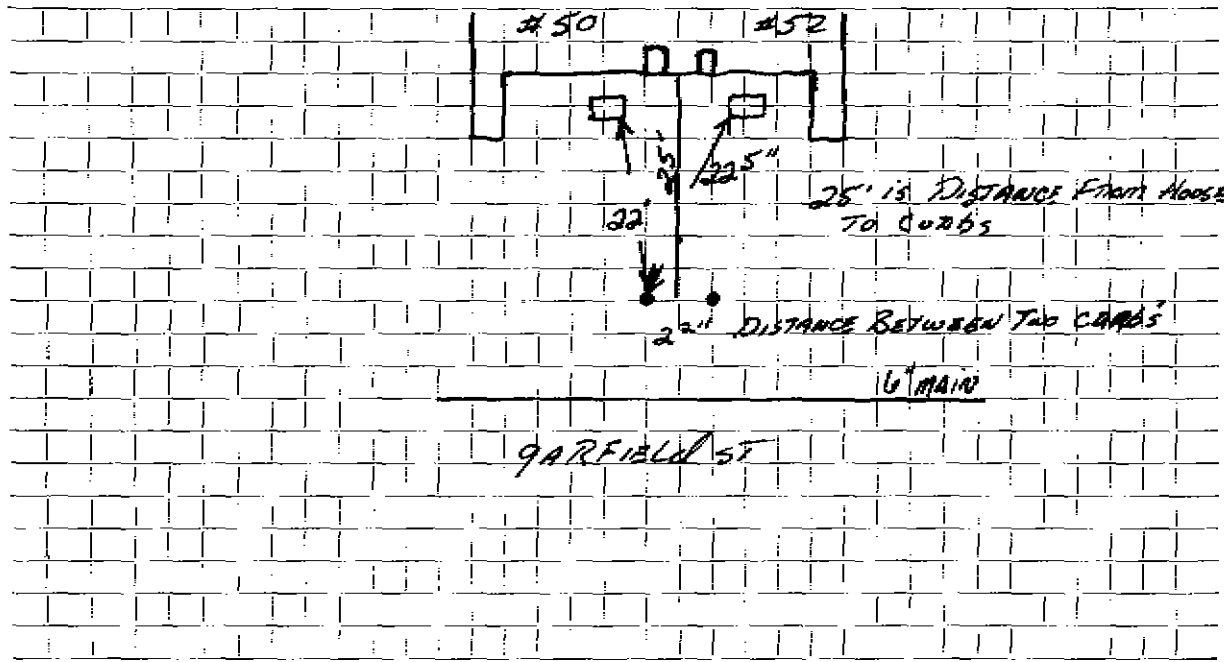

Connection made in Street. Work completed

Remarks:
.....
.....