

WATER SERVICE RECORD

Name Hall & Co., Realtors

Service No. 1

Address 6 Garfield Street

Location

~~Repair - Rework~~ - New Service ✓ DeFico Bros. # 2390 W.O. #1733


Comm 7-28-75

Date	Material	Amount	Total	Date	Amount
2-12-74	36' - 3/4" Copper			1-31-74 7-28-74	100.00 968 90.32
2-1-74	Labor	15.08			
	10 % O.H.	1.51	\$ 16.59		
	36' 3/4" Copper Pipe	@1.05	37.80		
	1 Curb Stop		12.45		
	1 Corporation		10.53		
	1 Box & Rod		12.95		
			\$90.32		

DATE _____

TOWN OF LEXINGTON — BOARD OF PUBLIC WORKS

WATER DIVISION

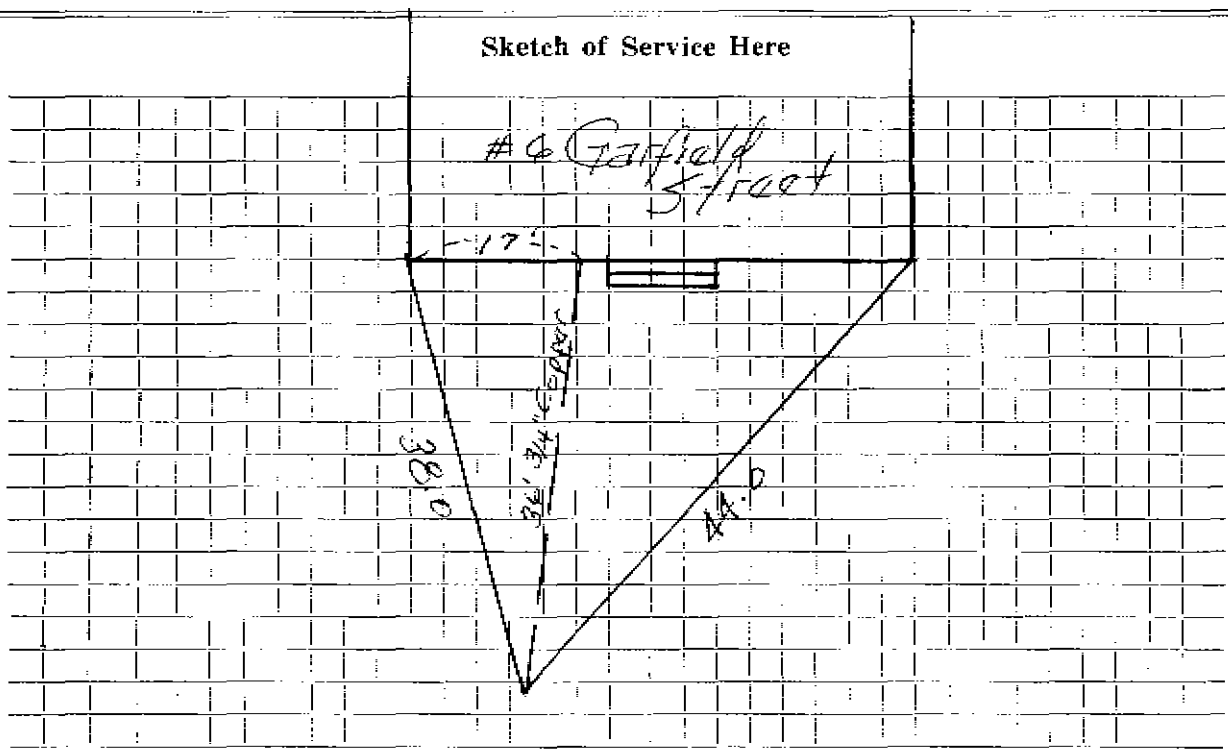

Connection made in Street. Work completed

Remarks:

.....

.....