


DATE 15 August 1996

TOWN OF LEXINGTON — BOARD OF PUBLIC WORKS

WATER DIVISION

Sketch of Service Here

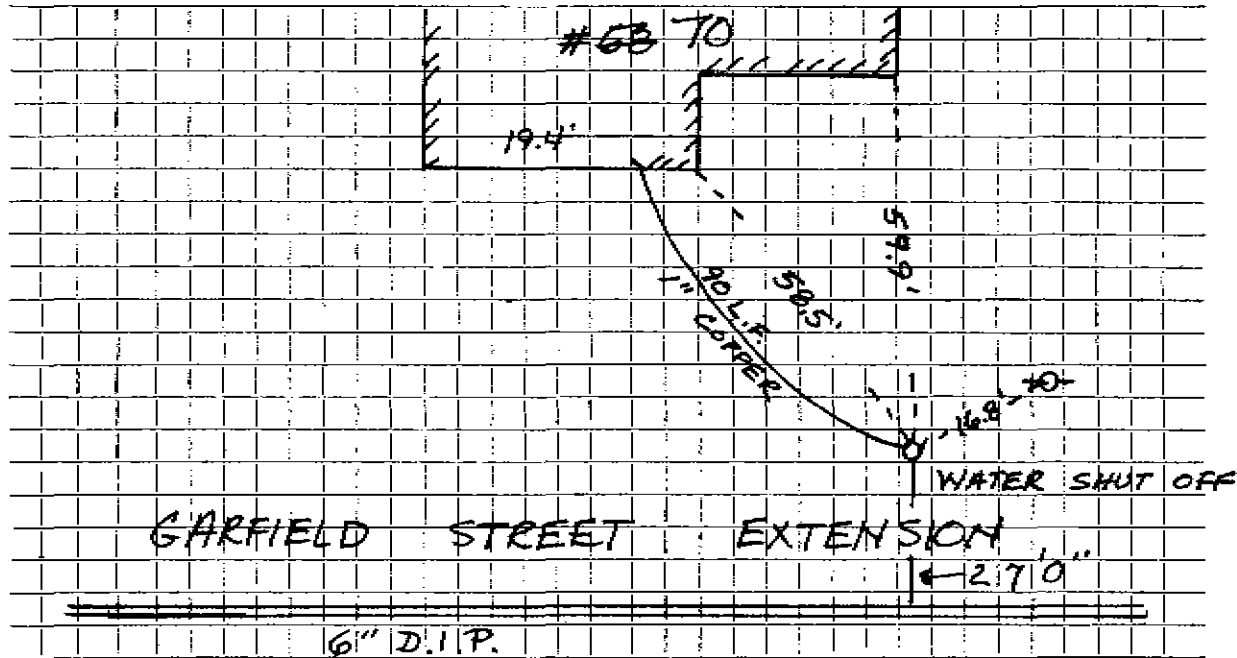

Connection made in GARFIELD ST. EXT. Street. Work completed FHP Construction

Remarks: