

WATER SERVICE RECORD

Name *Playground*

Service No.

Address *Garfield Street*

Location *Drinking Fountain*


Repair—Renewal—New Service

Date	Material	Amount	Total	Date		Amount
<i>6/30/83</i>	<i>12' 1" Copper tubing</i>					
					<i>OUTSIDE</i>	
				<i>6/30/83</i>	<i>26' 1" Copper tubing</i>	
					<i>1 1" Corp</i>	
					<i>1 1" Curb</i>	
					<i>1 Box & Rod</i>	

DATE _____

TOWN OF LEXINGTON — BOARD OF PUBLIC WORKS

WATER DIVISION

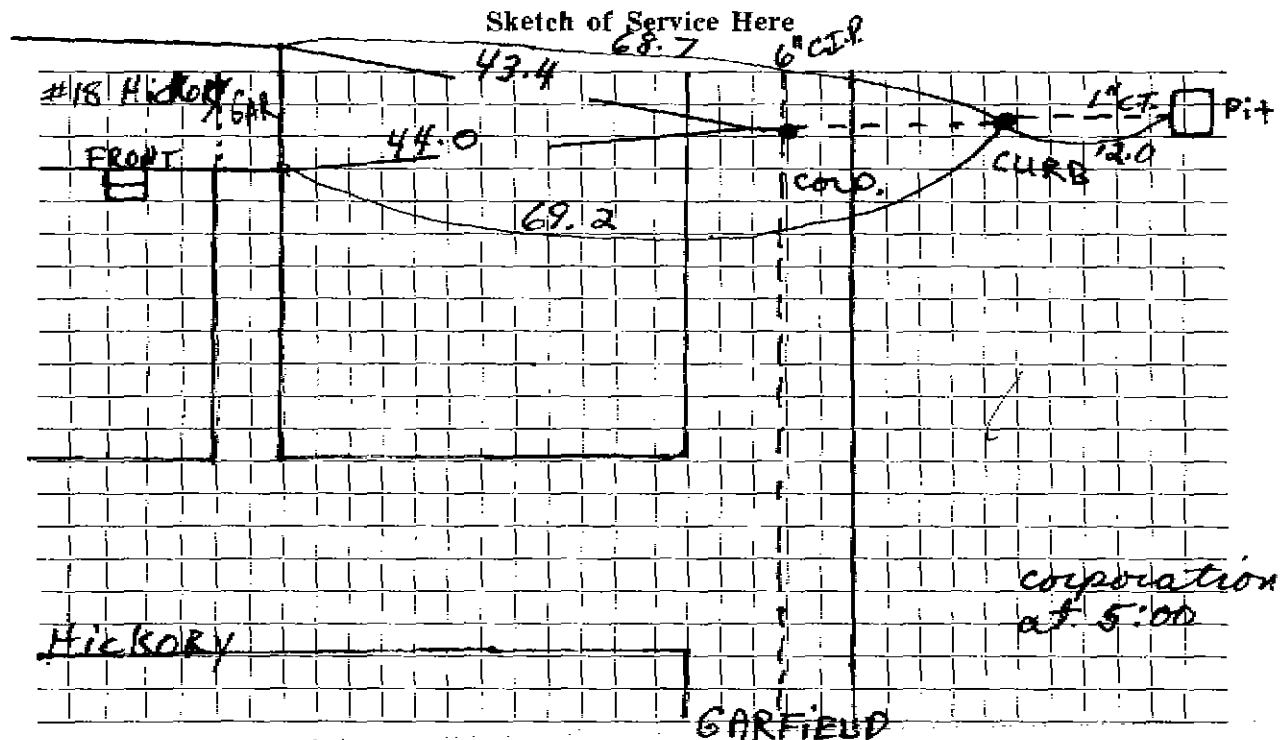

Connection made in Street. Work completed

Remarks:

.....

.....