

WATER SERVICE RECORD

3038

Name Dianne D'states

Service No. 124

Address 3 Gerard Terrace

Location

~~Repair~~ ~~CRANE~~ - New Service


Comm 8-22-60

Date	Material	Amount	Total	Date	Material	Amount
7-18-60	Labor	2 21		7-15-60	Deposit	50 00
	10% O.H.	22	2 43	8-23-60	Retard	5 81
79'	3/4" Copper tubing@42		33 18			44 19
1	3/4" Cxg I.W.H. Stop Waste		6 17			
1	3/4" C3 Part Union		2 41			
			44 19		NON CHARGE	
				7-18-60	Labor	2 11
					15' 3/4" Copper tubing@42	6 30
					1 3/4" C Corp cock	4 91
					1 3/4" C Curd cock	6 28
					1 Box & Rod	4 90
					1 3/8" Straight tailpiece	50
					1 1/2" Offset tailpiece	50
						25 50

DATE _____

TOWN OF LEXINGTON — BOARD OF PUBLIC WORKS
WATER DIVISION

Sketch of Service Here

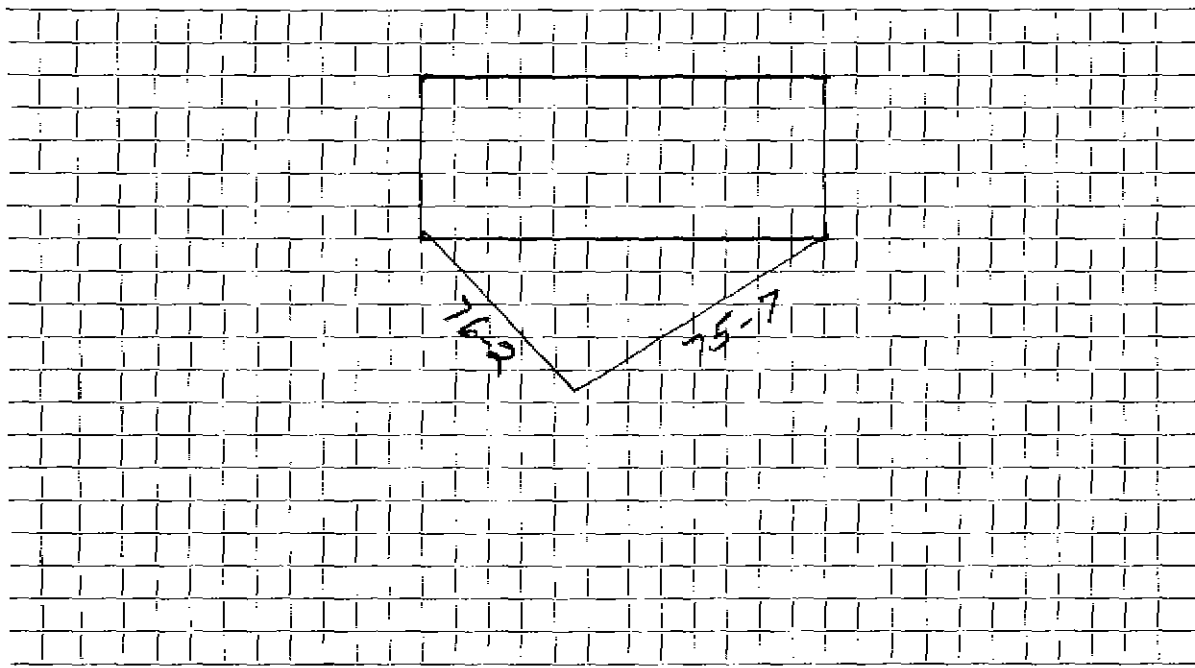

Connection made in Street. Work completed

Remarks:
.....
.....