

WATER SERVICE RECORD

Name Dianne EstatesService No. 125Address 4 Gerard Terrace# 2510# 6900

Location


Repair ~~Renewal~~ New ServiceCons 8-22-60

Date	Material	Amount	Total	Date	Amount
7-18-60	Labor	2 21		7-18-60	Deposit
	10% O.H.	22	2 43	8-22-60	Refund
	Owner's copper				3 60
1	3/4" Cx ¹ I.W.H. Stop & Waste		6 17		
			8 60		NON CHARGE
				7-18-60	Labor
				75'	3/4" Copper tubing@.78
				1	3/4" C Corp Cock
				1	3/4" C Corp cock
				1	Box & Rod
				1	1/2 Straight tailpiece
				1	1/2 Offset tailpiece
					77 70

TOWN OF LEXINGTON — BOARD OF PUBLIC WORKS

WATER DIVISION

Sketch of Service Here

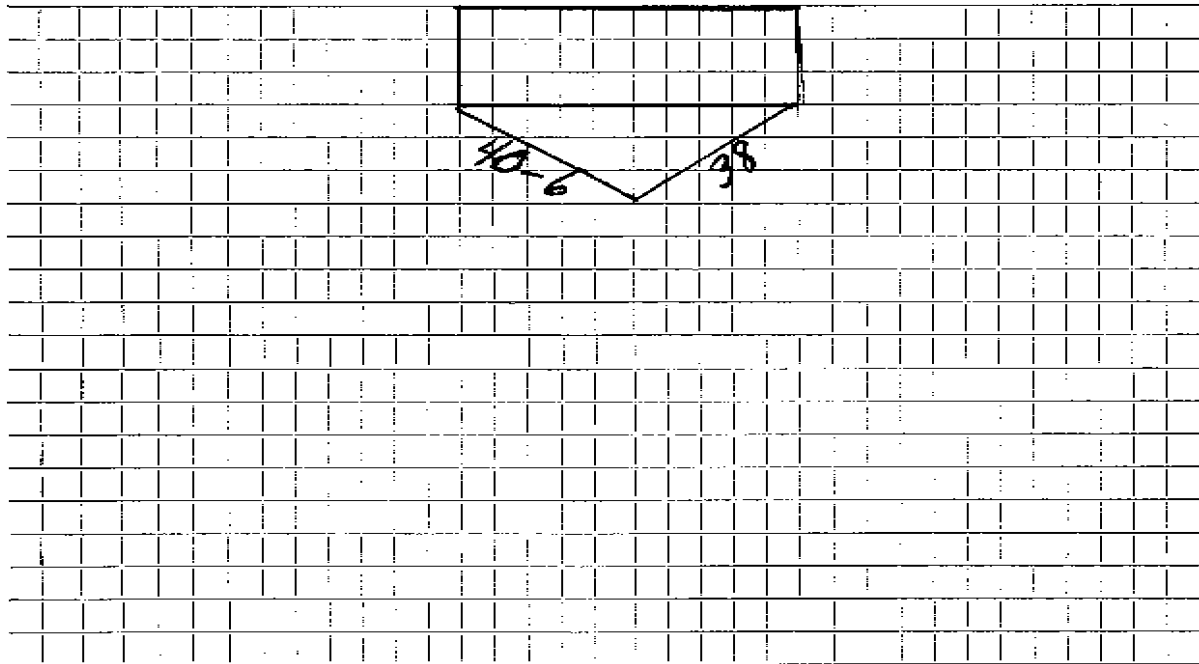

Connection made in Street. Work completed

Remarks:

.....

.....