

## WATER SERVICE RECORD

#5331

Name Diane Estates

Service No. 126

Address 5 Gerard Terrace

Location

~~Repair~~ ~~Renewal~~ New Service

Comm 8-22-60


Date	Material	Amount	Total	Date	Amount	
7-18-60	Labor	2 21		7-15-60	Deposit	50 00
	10% O.E.	22	2 43	8-22-60	Refund	16 20
	60' 3/4" Copper tubing	342	25 20			33 80
	1 3/4" Cx 1/2 I.W.F. Stop Valve	6 17				
			33 20		NOT CHARGE	
					Labor	2 21
					46' 3/4" Copper tubing	378-35 88
					1 3/4" C Corp Cock	4 91
					1 3/4" C Barb Cock	6 28
					1 Box & Rod	4 90
					1 1/2 Straight tailpiece	50
					1 1/2 Offset tailpiece	60
						55 08

DATE \_\_\_\_\_

TOWN OF LEXINGTON — BOARD OF PUBLIC WORKS

**WATER DIVISION**

Sketch of Service Here

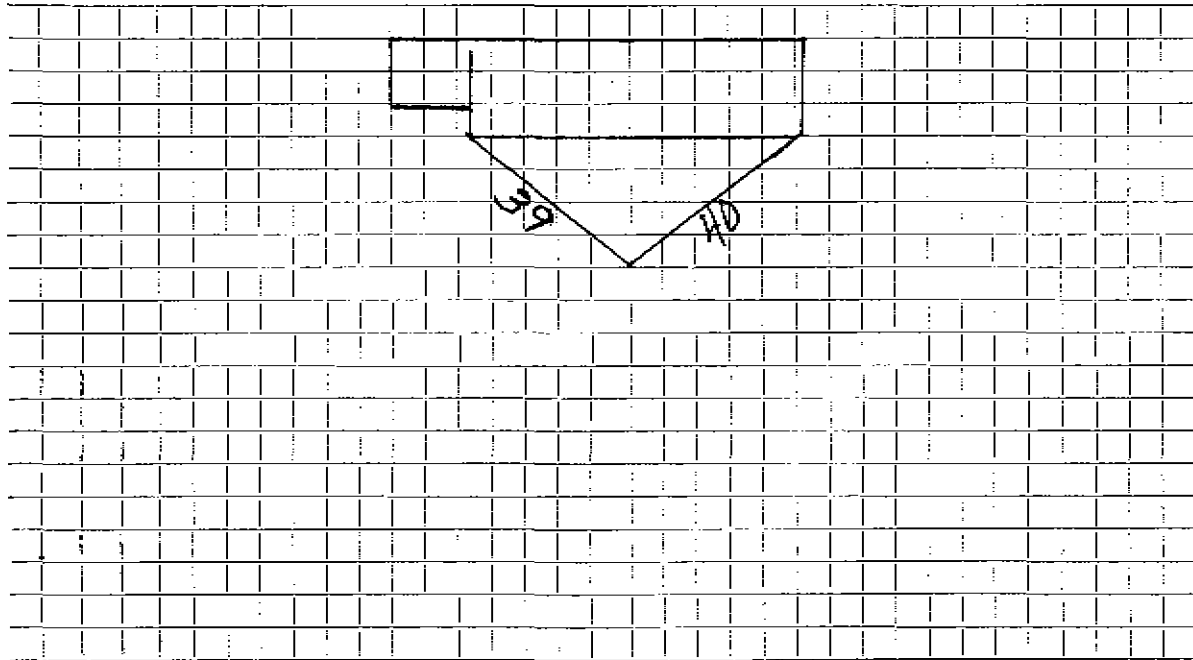

Connection made in ..... Street. Work completed .....

Remarks: .....

.....

.....