

WATER SERVICE RECORD

Name Dianne EstatesService No. 161Address 6 Gerard Terrace

Location

~~XXXXXXXXXX~~ New ServiceComm 8-22-60


Date	Material	Amount	Total	Date	Amount
8-5-60	Labor	1 94		8-5-60	Deposit 50 00
	10% O.H.	19	2 13	8-22-60	Refund 22 49
	40' 3/4" Copper tubing @42		16 80		27 51
	1 3/4" Cx 1/2 I.W.H. Stop & Waste		6 17		
	1 3/4" C3 part Union		2 41		NON CHARGE
			27 51		Labor 1 77
					58' 3/4" Copper tubing @42 24 36
					1 3/4" C Corp Cock 4 91
					1 3/4" C Curb Cock 6 28
					1 Box & Rod 4 90
					1 1/2 Straight tailpiece 50
					1 1/2 Offset tailpiece 50
					43 22

DATE _____

TOWN OF LEXINGTON — BOARD OF PUBLIC WORKS

WATER DIVISION

Sketch of Service Here

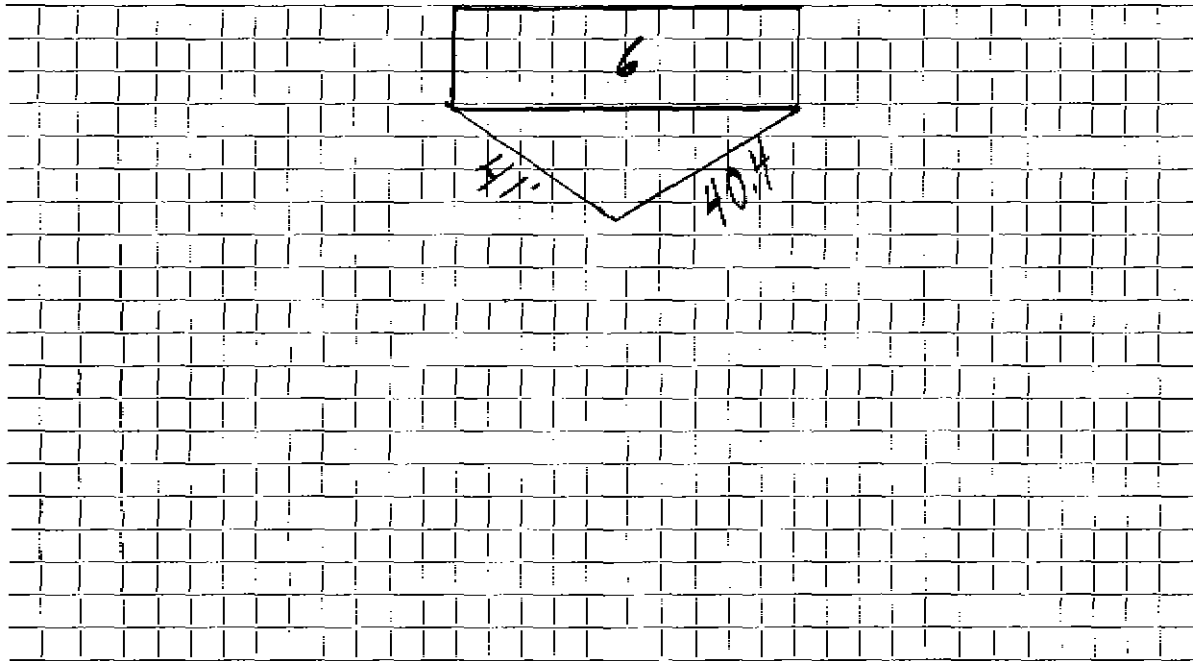

Connection made in Street. Work completed

Remarks:

.....
.....