

## WATER SERVICE RECORD

Name Bernard Maloney

Service No. 67

Address 5 Gibson Road

Location

~~Repair of Service~~ - New Service

Comm 7-12-61


Date	Material	Amount	Total	Date	Amount
6-8-61	Labor	78.67		6-21-61	Deposit 100.00
	10% O.H.	7.87	86.54		
	169' 1" Copper Tubing @.56		94.64		
1	3/4" c x 1/8 I.W.H. Stop & Waste	6.17			NON CHARGE
2	1" 3 part unions @3.98		7.96	11-23-60	Labor 7.87
5	Hrs. Town Shovel @6.50		32.50	33'	1" Copper tubing @.56 18.48
2	Hrs. Trucking @3.00		6.00	1	1" C Corp Cock 7.31
2	Hrs. Allis Chalmers @3.00		6.00	1	1" C Curb Cock 8.06
			239.81	1	Box & Rod 4.90
				1	hr. Town Shovel @6.50 6.50
				1	hr. Trucking @.75 75
					53.87
				6-8-61	1 1/2 Straight tailpiece .50
					1 1/2 Offset tailpiece .50
				1	1" Curb Cock 8.06
					62.93
				7-31-61	Advised 137.68

DATE \_\_\_\_\_

TOWN OF LEXINGTON — BOARD OF PUBLIC WORKS

WATER DIVISION

Sketch of Service Here

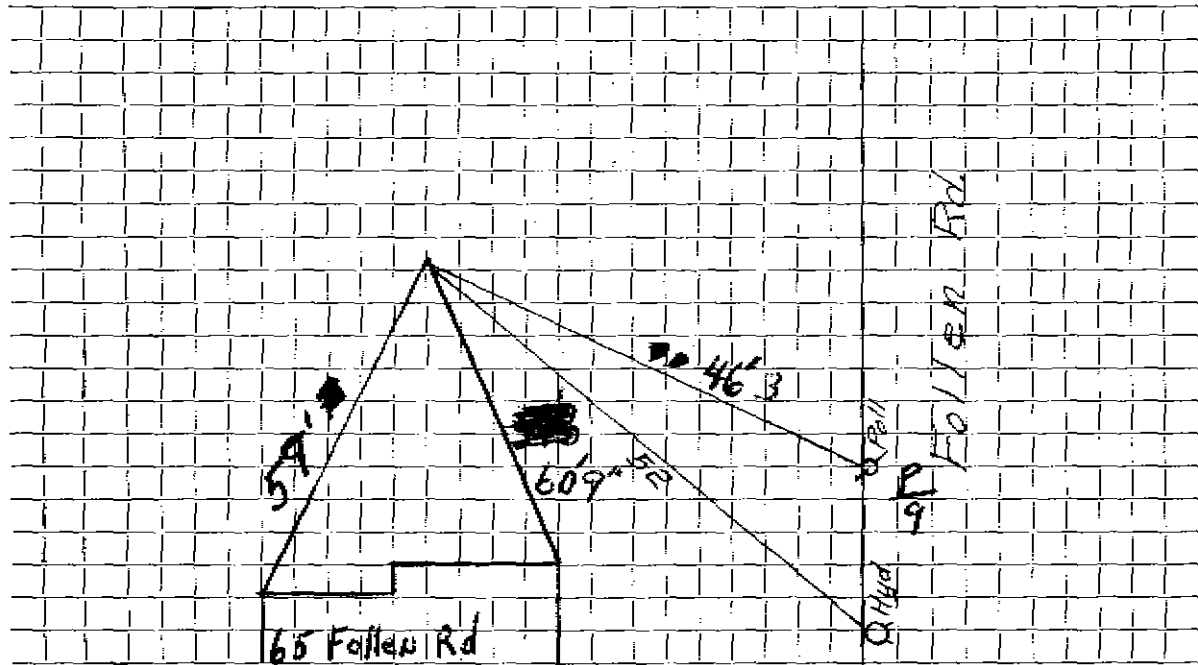

Connection made in ..... Street. Work completed .....

Remarks: TIE For Curb 5 Gibson Rd.