


DATE 11/17/18

TOWN OF LEXINGTON — BOARD OF PUBLIC WORKS
WATER DIVISION

Sketch of Service Here

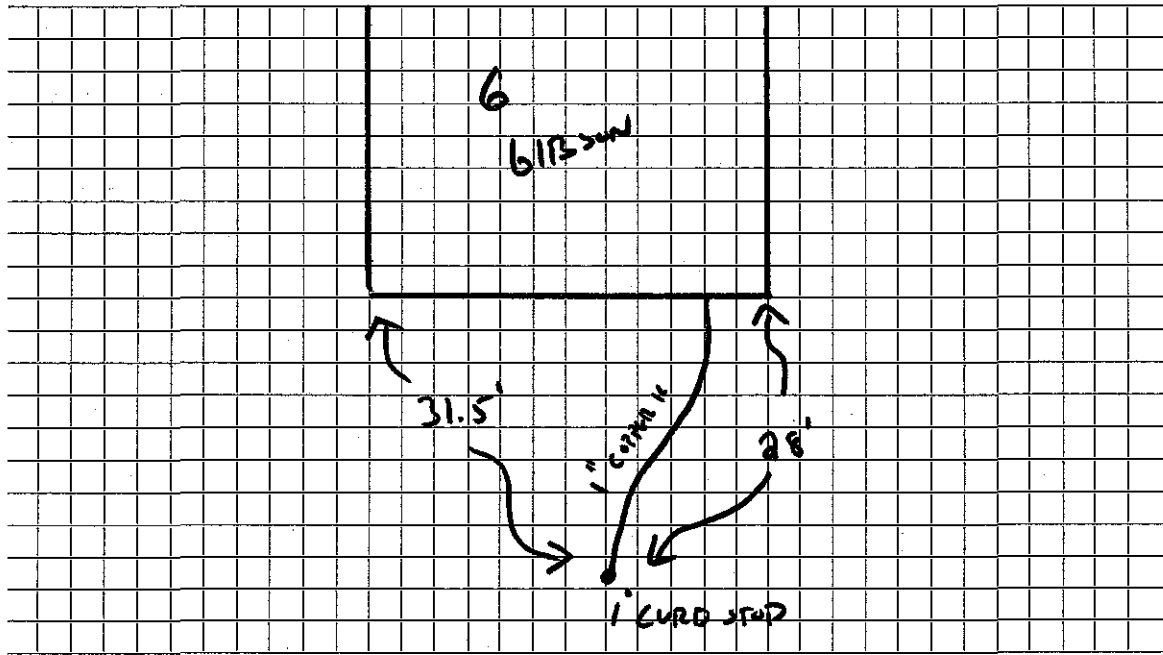

Connection made in 613 SW Street. Work completed PAU-YOUNG

Remarks:

.....

.....