

Name T. A. Custance
 Address 100 Gleason Road,

Service No. ~~72~~ 1031

Location

Kind of Pipe

Size

Size of Main

Repair—Renewal—New Service

Location

| Date | Material | Amount | Total | Date | Amount |
|------------------|----------------------------|--------|-------|---------------------------|--------|
| 1941 | | | | | |
| June 20, 1941 | 2 hrs. @ 60¢ | 1 20 | | <i>July 31, 1941 Paid</i> | 13 79 |
| <i>Jan 24/41</i> | 10% Overhead | 12 | 1 32 | | |
| | 36' 1" Copper tubing @ 22¢ | | 7 92 | | |
| | 1 1" Stop & Waste | | 2 25 | | |
| | 1 3/4" Bushing | | 25 | | |
| | 1 1" Copper Bend | | 1 30 | | |
| | 1 hr. Trucking | | 75 | | |
| | | | 13 79 | | |
| | Labor | | | | |

Jindley Press, Inc., Lexington

DATE _____

TOWN OF LEXINGTON—BOARD OF PUBLIC WORKS

WATER DIVISION

The undersigned applies for a supply of water at No. _____ St. and hereby agrees to comply with the rules and regulations as now, or at any future time, established by the Board of Selectmen.

Am't. of Estimate \$ _____


Owner _____

Am't. Paid \$ _____

Address _____

Builder _____

Sketch of Service Here

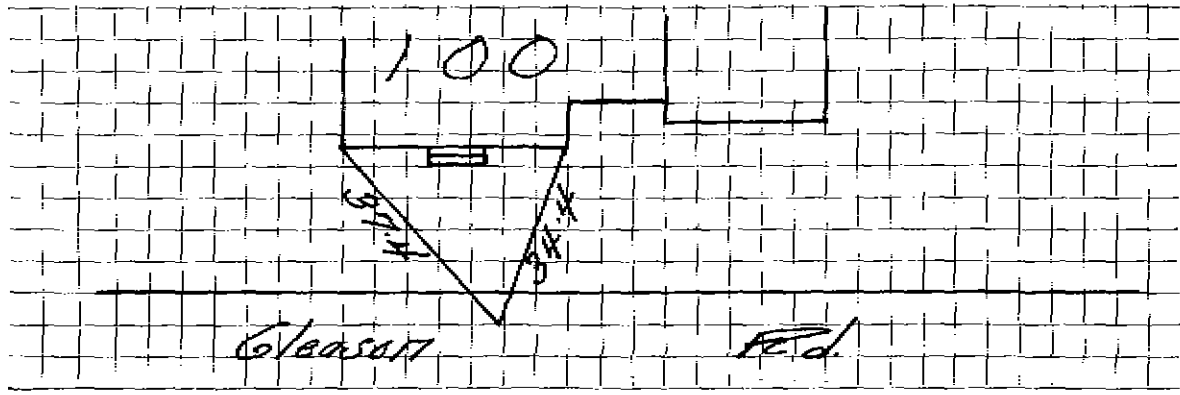

Connection made in _____ Street.

Work completed _____ 19

Remarks: