

Name John F. Mayer

Service No. 61

Address 103 Gleason Road

Lexington, Mass.

Location 103 Gleason Road

Kind of Pipe

Size

Size of Main

XXXXXXX
Repair - ~~Renewal~~ - New Service

Com. 9-26-49

Location

Date	Material	Amount	Total	Date	Amount
Aug. 24, '49	Labor	1 25	1 25	July 28 '49	20 00
	10% Overhead		13	July 30 '49	6 62
	33' - 3/4" Copper Tubing @ .24		7 92	Refunded	18 34
	1 - 3/4" C x 1/2" I.W.E. S&W		3 29	No Charge	
	Trucking 1 hr. @ .75		75	Aug. 24, '49 Labor	1 25
			<u>13 34</u>	14' - 3/4" Copper Tubing @ .24	3 36
				1 - 3/4" C Corp-cock	3 15
				1 - 3/4" C x 3/4" C Surb-cock	3 85
				1 - Box & Rod	3 75
				1 - 1/2" Straight Tail Piece	37
				1 - 1/2" Offset Tail Piece	37
				Trucking 1 hr. @ .75	75
					<u>16 85</u>
	Labor				

TOWN OF LEXINGTON - BOARD OF PUBLIC WORKS
WATER DIVISION

The undersigned applies for a supply of water at No. St. and hereby agrees to comply with the rules and regulations as now, or at any future time, established by the Board of Selectmen.

Am't of Estimate \$.....


Owner

Am't Paid \$.....

Address

Builder

Sketch of Service Here

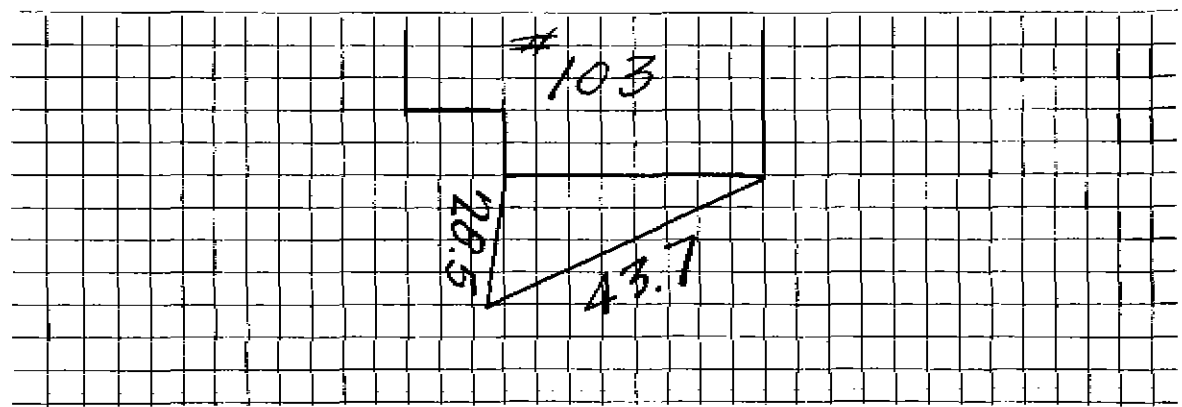

Connection made in Street.

Work completed19

Remarks: