




DATE \_\_\_\_\_

TOWN OF LEXINGTON — BOARD OF PUBLIC WORKS  
**WATER DIVISION**

Sketch of Service Here

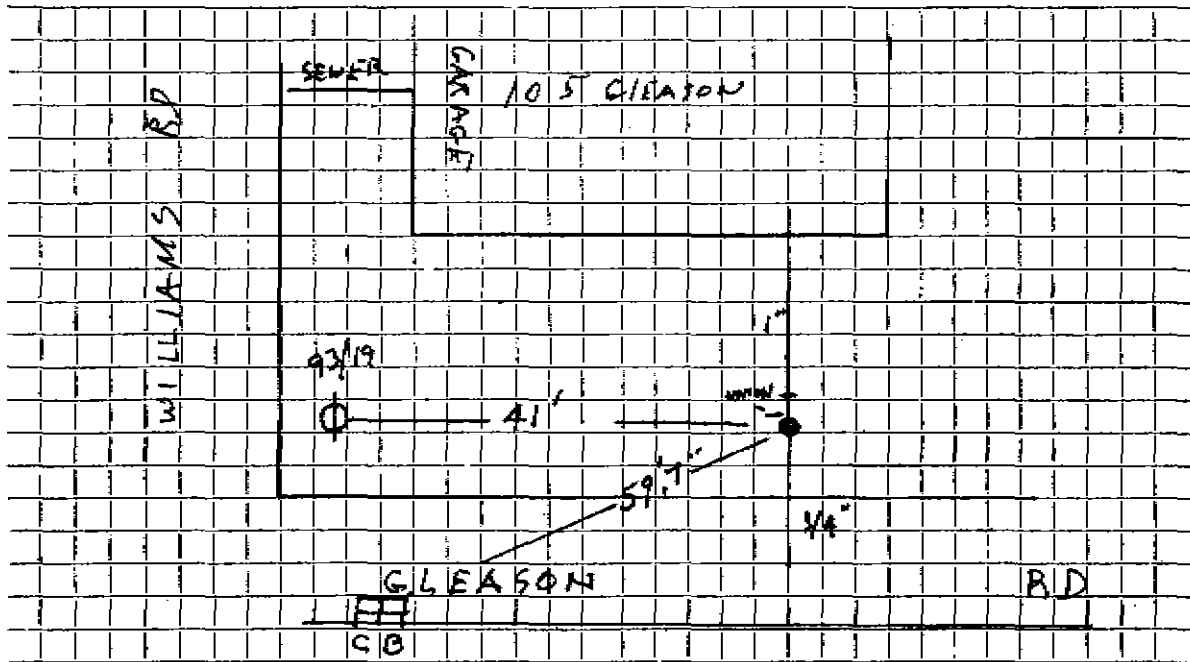

Connection made in GLEASON RD..... Street.      Work completed .....

Remarks: .....

.....

.....