

Name Ruth Mitchell  
 Address 106 Gleason Road  
 Lexington, Mass.

Service No. 240

Location

Kind of Pipe

Size

Size of Main

Repair—Renewal—New Service

Location

Date	Material	Amount	Total	Date	Amount
Nov. 2, '48	Labor	1 25	1 25	Oct. 11, '48	20 00
	10% Overhead		13	Dec 1, '48	1 18
	48'-3/4" Copper Tubing @ .255	12 24	12 24		17 62
	1-3/4" C x 1/2" I.W.H S&W	3 15	3 15		
	1 hr. Trucking		75	Nov. 2, '48	1 25
			17 52	26'-3/4" Copper Tubing @ .255	6 63
				1-3/4" C. Corp-cock	3 00
				1-3/4" C x 3/4" C. Curb-cock	3 68
				1-Box & Rod	3 55
				1-1/2" Offset Tail Piece	30
				1-1/2" Straight Tail Piece	30
				1 hr. Trucking	75
					19 46
	Labor				

TOWN OF LEXINGTON - BOARD OF PUBLIC WORKS

**WATER DIVISION**

The undersigned applies for a supply of water at No..... St. and hereby agrees to comply with the rules and regulations as now, or at any future time, established by the Board of Selectmen.

Am't of Estimate \$.....

Owner .....


Am't Paid \$.....

Address .....

Builder .....

.....

Sketch of Service Here

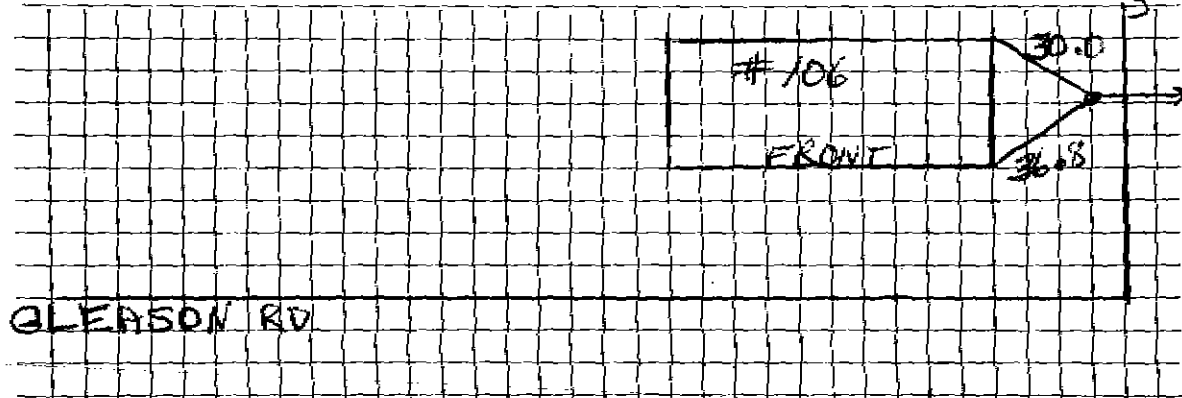

Connection made in ..... Street.

Work completed .....19

Remarks: