

Name Maria Leighton

Service No. #1034

Address 11 & 12 Gleason Rd. c/o W. Bowman Judkins)

Location Lots 11 & 12 Gleason Road

Kind of Pipe

Size

Size of Main

~~Repair~~ ~~Renewal~~ New Service

Location

Date
1936

Material

Amount

Total

Date

Amount

10-26-36

3 hrs. @ 60¢

1 80

1 98

Oct 26 1936 Deposited
Dec 9 1936 Repaid

36 00

Con 12-8-36

10% overhead

18

7 60

11 83

24 17

40' 3/4" Cop. Pipe @ 19¢

7 60

1 75

24 17

1 S. & W.

1 00

Trucking

1 00

12 33

Trench Repairs:

4 17

Say: Flat Rate: 40' @ 50¢

20 00

24 17

Labor

Hadley Press, Inc., Lexington

DATE Oct, 24, 1934

TOWN OF LEXINGTON—BOARD OF PUBLIC WORKS

WATER DIVISION

The undersigned applies for a supply of water at No. 11 & 12 Gleason St. and hereby agrees to comply with the rules and regulations as now, or at any future time, established by the Board of Selectmen.

Am't. of Estimate \$ 36.00 (21.00
15.00 T.R.)


Owner Maria Leighton

Am't. Paid \$ _____

Address By M. B. Judkin's
6 Colony Rd. Lex.

Builder M. B. Judkin

Sketch of Service Here

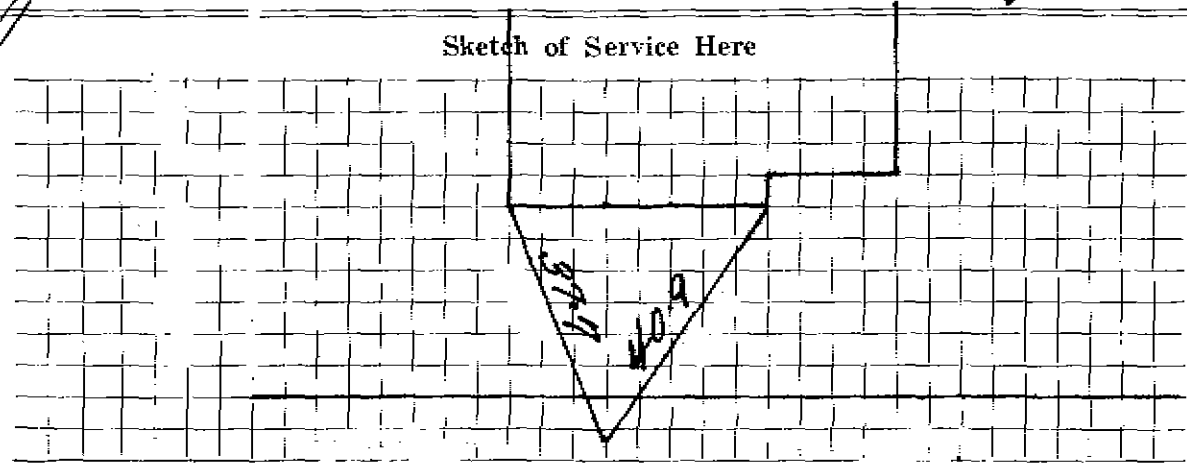

Connection made in _____ Street. Work completed _____ 19

Remarks: