

Name Hobart N. Crocker
 Address 20 No. Hancock St.
 14 Gleason Rd.

Service No. 1005 ~~38~~
 #5111

#14 Gleason Rd.
 Location rear, #20 No. Hancock St. (Gleason Rd.)

Kind of Pipe Size Size of Main

~~Repair - Renewal~~ - New Service

Location

Date	Material	Amount	Total	Date	Amount
7/7/33 9-19-33 Comm. 20.	36' water service @ .60 <u>SAY</u>	\$21 60	<u>\$20 00</u>	July 5, 1933 - Cash	20 -
	Labor			checked 12-10-92	Outside 3/4 Copper

Hadley Press, Inc., Lexington

DATE July 5, 1933

TOWN OF LEXINGTON—BOARD OF PUBLIC WORKS

WATER DIVISION

near #20, No. Hancock St.

The undersigned applies for a supply of water at No. Gleason Road St. and hereby agrees to comply with the rules and regulations as now, or at any future time, established by the Board of Selectmen.

Am't. of Estimate \$ 22


Owner Hobart N. Crocker

Am't. Paid \$ 21

Address 20 No. Hancock St
Lexington, Mass.

Builder _____

Sketch of Service Here

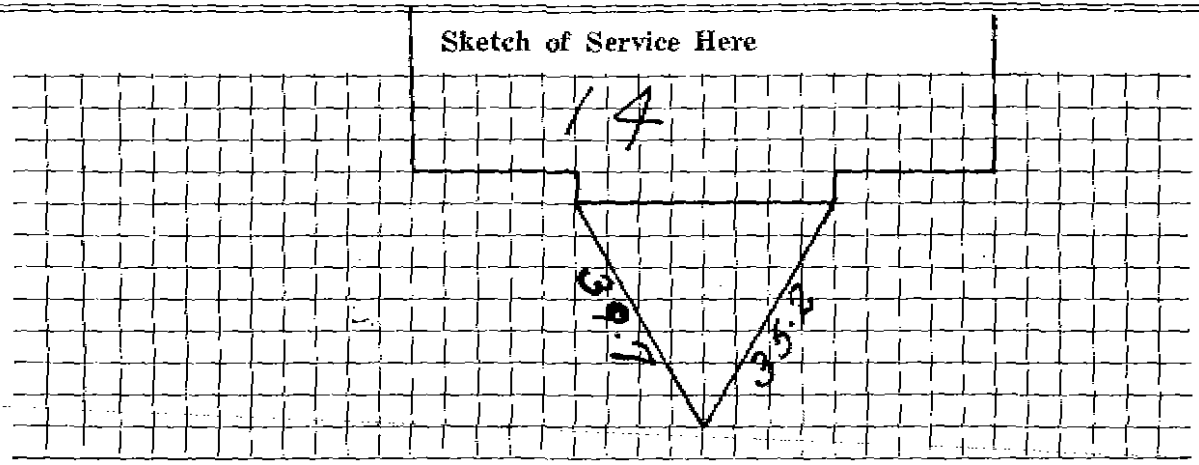

Connection made in _____ Street. Work completed _____ 19

Remarks: