


TOWN OF LEXINGTON — BOARD OF PUBLIC WORKS
DATE _____

WATER DIVISION

Sketch of Service Here

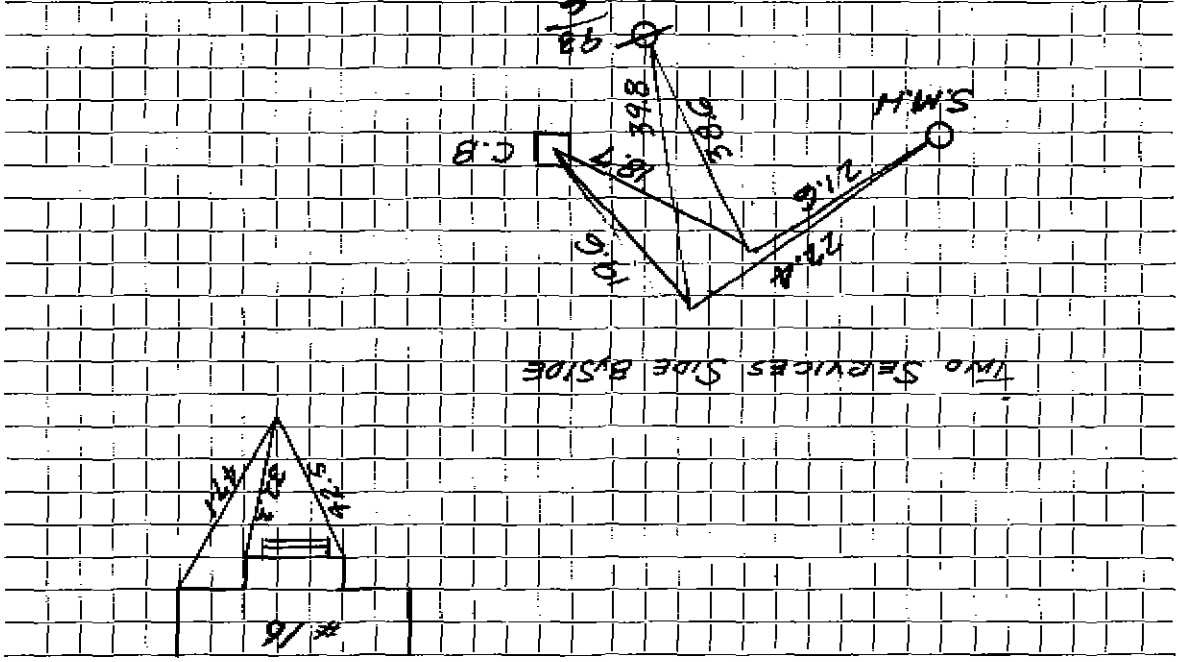

TWO SERVICES SIDE BY SIDE

Street. Work completed

Connection made in

Remarks: