


Water Service Tie Card
TOWN OF LEXINGTON

16 Gleason Rd

MASSACHUSETTS

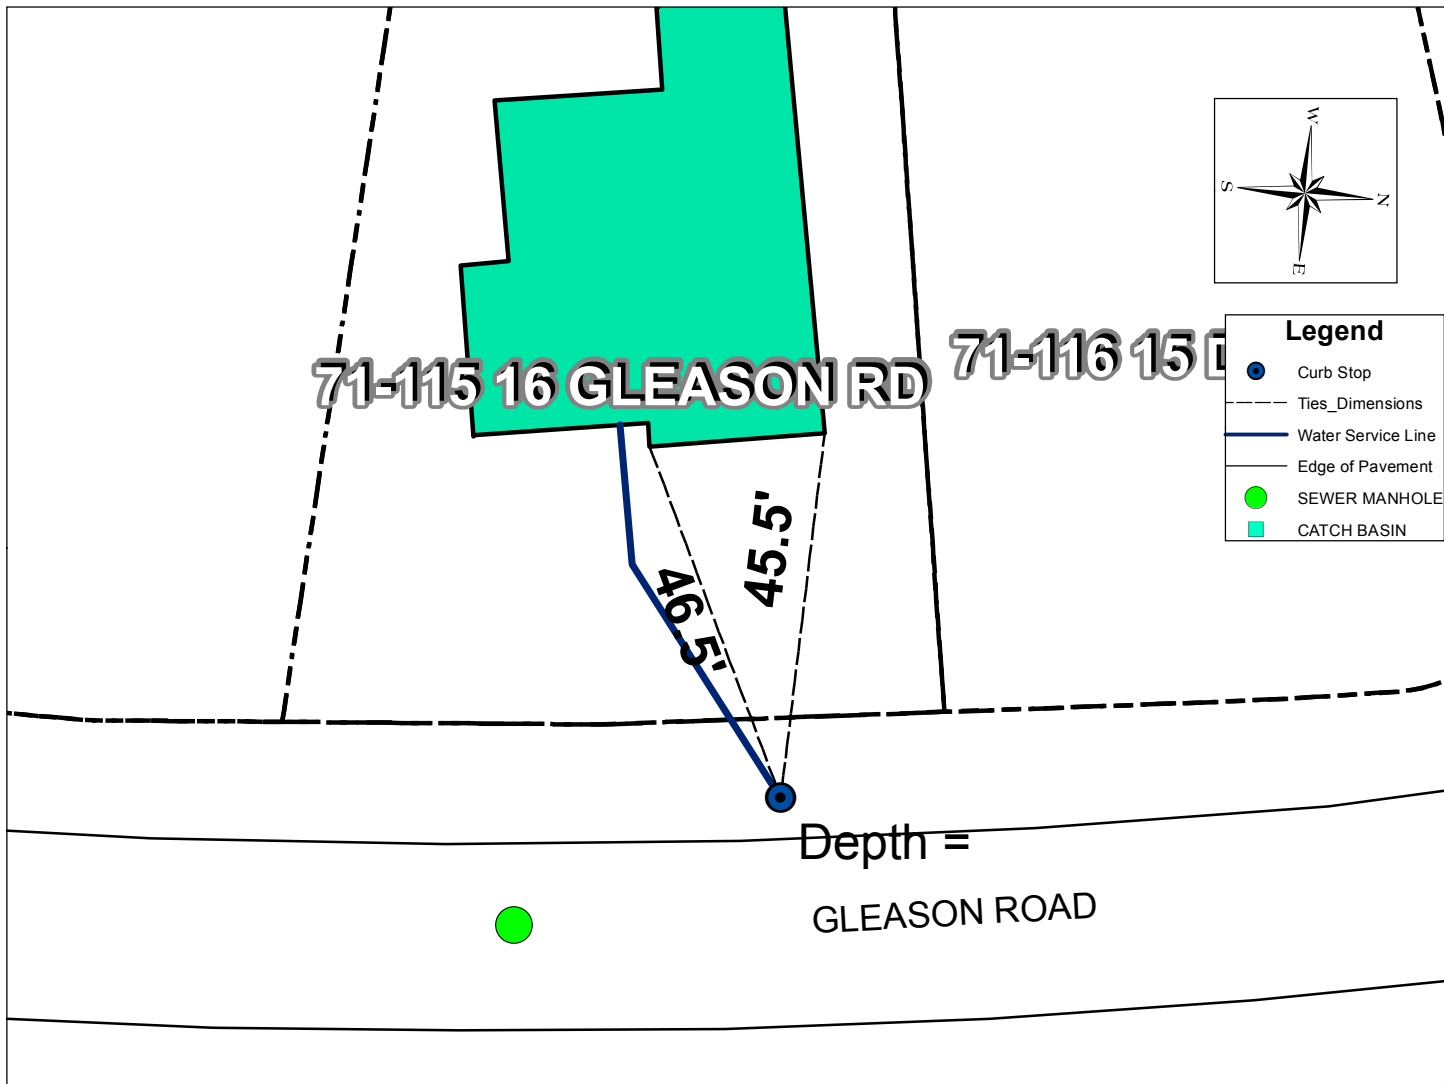

Address	Map and Lot	Permit Number	Contractor Name	Inspector
16 Gleason Rd	71-115	6232	McKee, Bruce J. Inc	dpavlik
Date	Material	Depth of Cover	Amount	
6/24/2015	3/4" Copper type "k"		2.5 ft	
	3/4" to 1" fitting		1	
	1" Copper type "k"		2.6'	
	1" Curb Valve and Buffalo Box		52 ft to house	
Type of work completed				

New 1" water service to house from curb stop. New house on lot old house removed.