

Name Lester W. McLellan  
 Address 27 Gleason Road  
 Lexington

Service No. 110  
 3048

Location 27 Gleason Road

Kind of Pipe Size Size of Main  
~~Repair - Repair~~ - New Service Com. 9-5-50 Location

Date	Material	Amount	Total	Date	Material	Amount
June 28 '50	Labor	1 50		May 28 '50	Reported	20 00
	10% Overhead	15	1 65			4 00
	42' - 3/4" Copper Tubing @ 23¢		9 66			18 35
	1 - 3/4" C x 1/2" I.W.H. S&W		3 29		No Charge	
	1 hr. Trucking		75	June 28 '50	Labor	1 50
			15 35		31' - 3/4" Copper Tubing @ 23¢	7 13
					1 - 3/4" C. Corp-cock	3 15
					1 - 3/4" C x 3/4" C. Gurb-cock	3 85
					1 Box & Rod	3 35
					1 - 1/2" Offset Tail Piece	38
					1 - 1/2" Straight Tail Piece	38
					1 hr. Trucking	75
	Labor					20 49

DATE \_\_\_\_\_

# TOWN OF LEXINGTON - BOARD OF PUBLIC WORKS

## WATER DIVISION

The undersigned applies for a supply of water at No. .... St. and hereby agrees to comply with the rules and regulations as now, or at any future time, established by the Board of Selectmen.

Am't of Estimate \$.....

Owner .....


Am't Paid \$.....

Address .....

Builder .....

.....

Sketch of Service Here

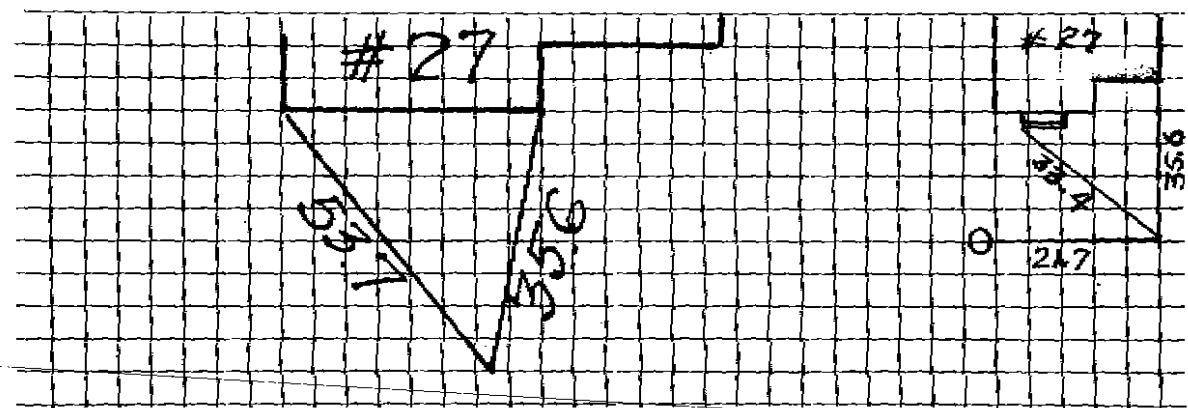

Connection made in ..... Street.

Work completed .....19

Remarks: