

125

WATER SERVICE RECORD

Name C. A. Temple

Service No. 153

Address 31 Gleason Road

Location Lexington, Mass.

Repair ~~General~~ - New Service


Com - 9-24-51

Date	Material	Amount	Total	Date	Amount
8/7/51	Labor	2 76	2 76	7-9-51	Deposited 50 00
	10% overhead		28	9-24-51	Refunded 3 28
	55' -3/4" copper tubing @ .326	17 93			<u>No Charge</u> 46 72
	1 -3/4" Cx1/2 I.W.F. stopwaste	4 00	8/7/51	Labor	8 28
	3 hrs. Littlefield shovel @7.	21 00		5' -3/4" copper tubing @ .326	1 63
	1 hr. trucking		75	1 -3/4" C corp-cock	4 33
			46 72	1 -3/4" Cx3/4" C.curb-cock	4 67
				1 box end rod	4 68
				1-1/2 offset tail piece	50
				1 -1/2 straight tail piece	50
				1 hr. Littlefield shovel	7 00
				1 hr. trucking	75
					32 34

DATE _____

TOWN OF LEXINGTON — BOARD OF PUBLIC WORKS
WATER DIVISION

Sketch of Service Here

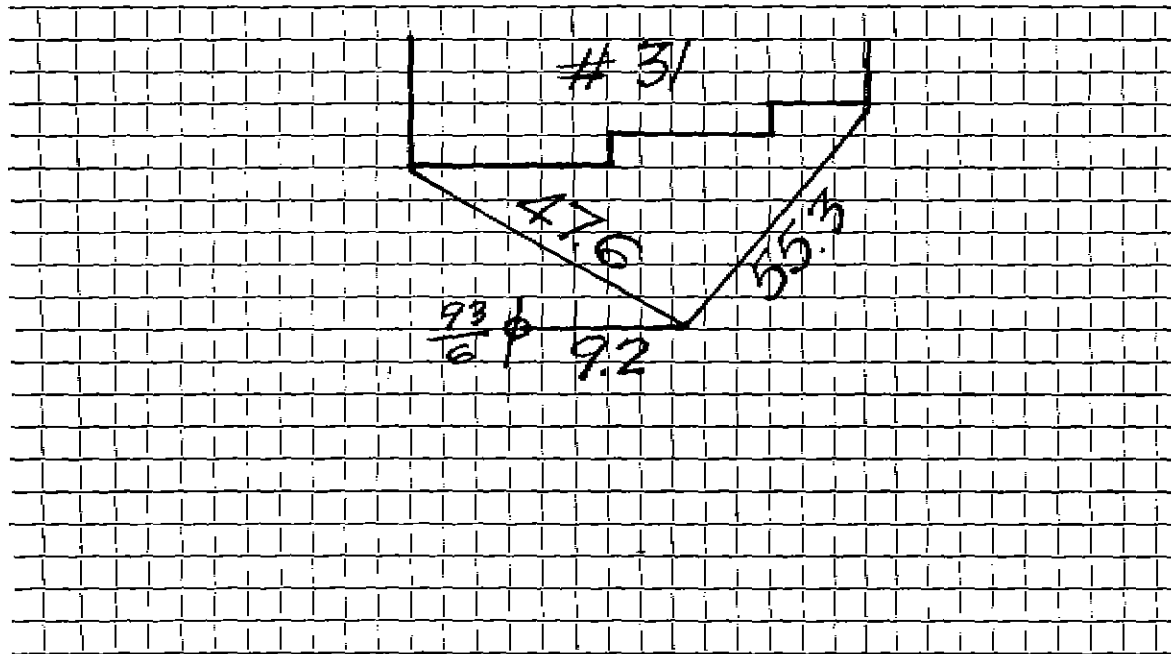

Connection made in Street. Work completed

Remarks:

.....

.....