

WATER SERVICE RECORD

Name ~~Block 5A~~ #34

Service No.

Address ~~1415~~ Gleason Road

Location


~~Repair-Renewal~~ New Service SERVICE IN TO CURB

Date	Material	Amount	Total	Date	Amount
	See 2nd CARD For 34				
					NON CHARGE
				10/26/53	Labor 1 75
					36'-3/4" Copper tubing. 3629 13 06
					1 - 3/4" C. corp-cock 4 33
					1 - 3/4" Cx5/4" C. curb-cock 4 67
					1 box and rod 3 90
					1hr. trucking 75
					<u>28 46</u>

DATE \_\_\_\_\_

TOWN OF LEXINGTON — BOARD OF PUBLIC WORKS  
**WATER DIVISION**

Sketch of Service Here

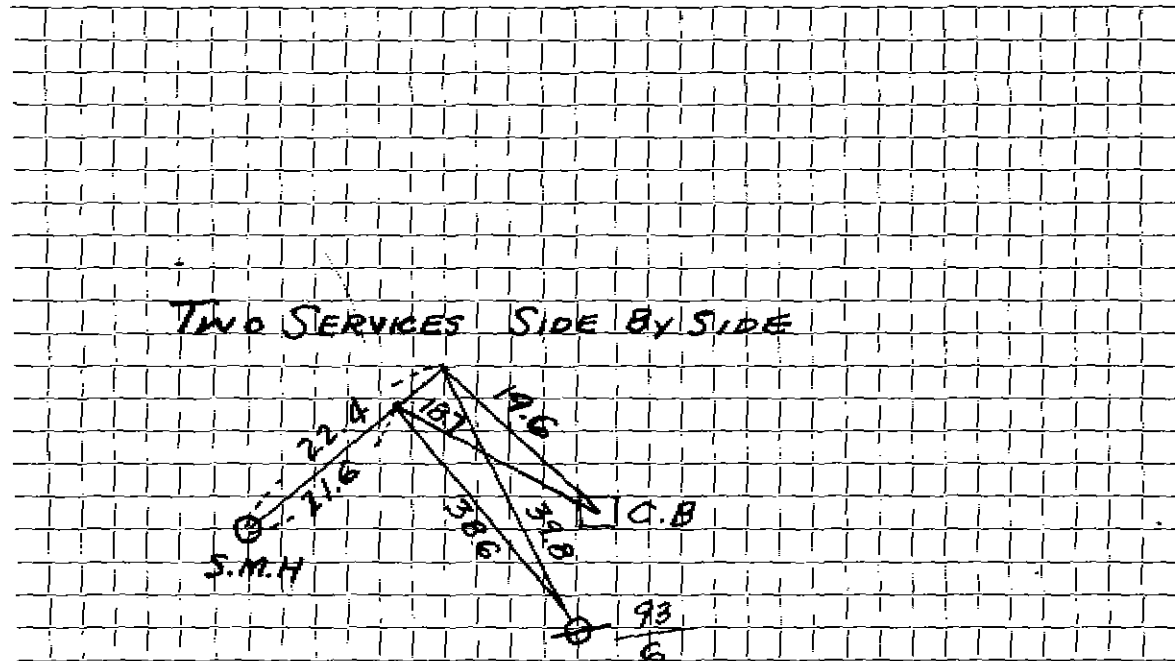

Connection made in ..... Street. Work completed .....

Remarks: .....

.....  
.....




DATE \_\_\_\_\_

TOWN OF LEXINGTON — BOARD OF PUBLIC WORKS

**WATER DIVISION**

Sketch of Service Here

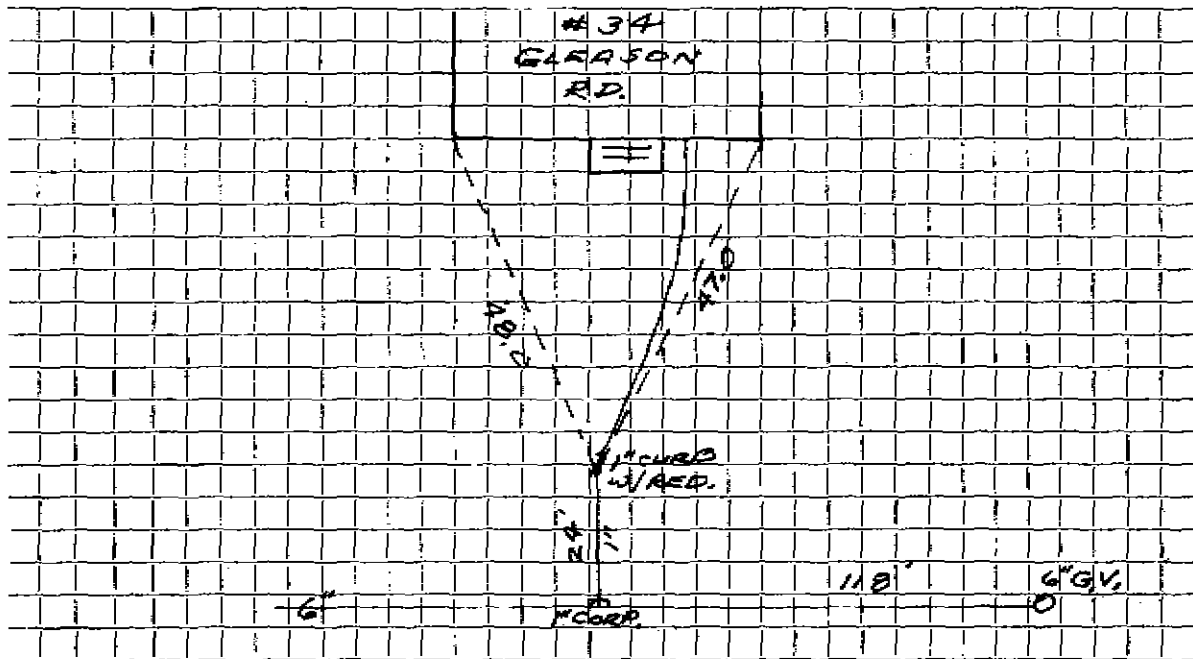

Connection made in GLEASON RD. Street. Work completed .....

Remarks: 3/4" INSIDE .....

.....  
.....