

Name L. G. McGonchie

Service No. ~~101~~ 1009

Address 84 Bertwell Road  
51 Gleason Rd.

Location

51 Gleason Road # 2543

Kind of Pipe

Size

Size of Main

Repair—Renewal—New Service

Location

Date  
1941

Material

Amount

Total

Date

Amount

September 3,  
*Com 10/13/41*

2 hrs. @ 60¢	1 20
10% Overhead	12
36' 3/4" Copper tubing @ 19¢	6 84
1 3/4" C. S. & W.	2 50
Trucking, 2 hrs. @ 75¢	1 50
Trench repairs	2 08
	<hr/>
	14 24

September 3, 1941  
*Deposited*  
*Refund*

25 00
10 76
<hr/>
14 24

Labor

*Handwritten notes at bottom right*

DATE Aug 26, 1941

TOWN OF LEXINGTON—BOARD OF PUBLIC WORKS  
WATER DIVISION

The undersigned applies for a supply of water at No. 51 Gleason Rd. St. and hereby agrees to comply with the rules and regulations as now, or at any future time, established by the Board of Selectmen.

Am't. of Estimate \$ 75.00

*owner dig*

Owner

Leland G. McConchie


Am't. Paid \$ \_\_\_\_\_

Address

84 Bestwick Rd  
Lexington

Builder \_\_\_\_\_

Sketch of Service Here

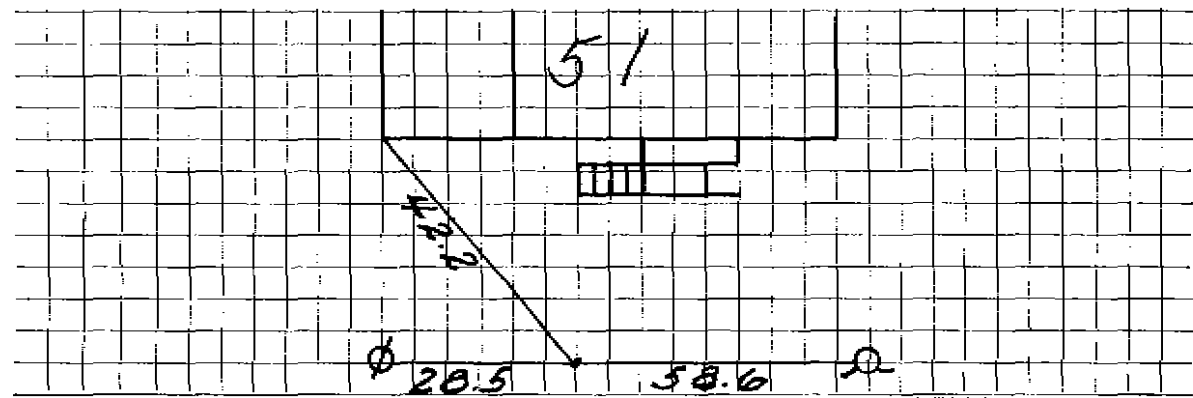

Connection made in \_\_\_\_\_ Street.

Work completed \_\_\_\_\_ 19

Remarks: