

WATER SERVICE RECORD

Name

Service No.

Address *52 Gleason*

Location

Repair—Renewal—New Service


Date	Material	Amount	Total	Date	Amount
<i>5-22-28</i>	<i>37' 1" CL Pipe</i>				
	<i>2 1" L.L. Coyr</i>			<i>3/4</i>	<i>Outside:</i>
	<i>1 1" L.L. ELL</i>				<i>Copper</i>
	<i>1 1" Br. Sp. Nipple</i>				<i>1 Cop-Iron Adp.</i>
					<i>1- 3/4 Comp Curb</i>
					<i>1- 3/4 Comp 3rd union</i>
					<i>1 Box + Rod</i>

DATE 9-17-92

TOWN OF LEXINGTON — BOARD OF PUBLIC WORKS

WATER DIVISION

Sketch of Service Here

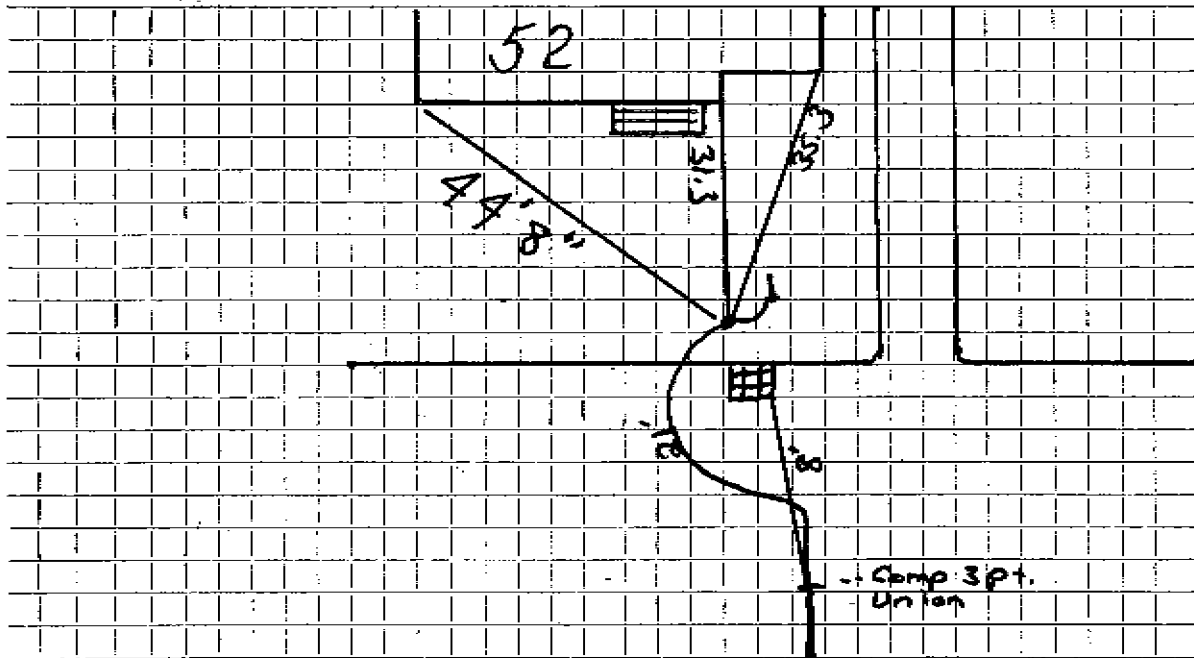

Connection made in Street. Work completed 9-17-92

Remarks: 21' of copper from curb to 3pt union gas around catch basin

New 1" curb stop is 4" from old curb stop towards home. 1" to 3/4" adapter and new 1" copper type k pipe from new curb stop to home.