

Name Joseph Napoli

Service No. ~~78~~ 1012

Address 39 Tucker Avenue
55 Gleason Rd.

Location 55 Gleason Road

Kind of Pipe

Size

Size of Main

~~Repair~~ ~~Renewal~~ — New Service

Location

Date 1939	Material	Amount	Total	Date	Amount
12/15/39	5 hrs. @ 55¢	2 75			
<i>Com 1-22-40</i>	2 " @ 60¢	1 20		December 12, 1939 Deposited	30 00
	2 " @ 65¢	1 30	5 25	January 29, 1940 Refunded	7 05
	10% Overhead		53		
	48' 3/4" Copper tubing @ 19¢		9 12		
	1 3/4" Cx 1/2" I.S. & W.		2 10		
	2 hrs. trucking @ 75¢		1 50		
	Trench repairs		4 45		
			22 95		
	Labor				

Hadley Press, Inc., Lexington

41 30-00

22.60
4.50
30.00

DATE Dec 17, 1929

TOWN OF LEXINGTON—BOARD OF PUBLIC WORKS

WATER DIVISION

The undersigned applies for a supply of water at No. 55 Gleason Rd. St. and hereby agrees to comply with the rules and regulations as now, or at any future time, established by the Board of Selectmen.

Am't. of Estimate \$ 30.

Owner Joseph Napoli


Am't. Paid \$ 30.

Address 39 Tucker Ave

Builder Joseph Napoli

Lexington

Sketch of Service Here

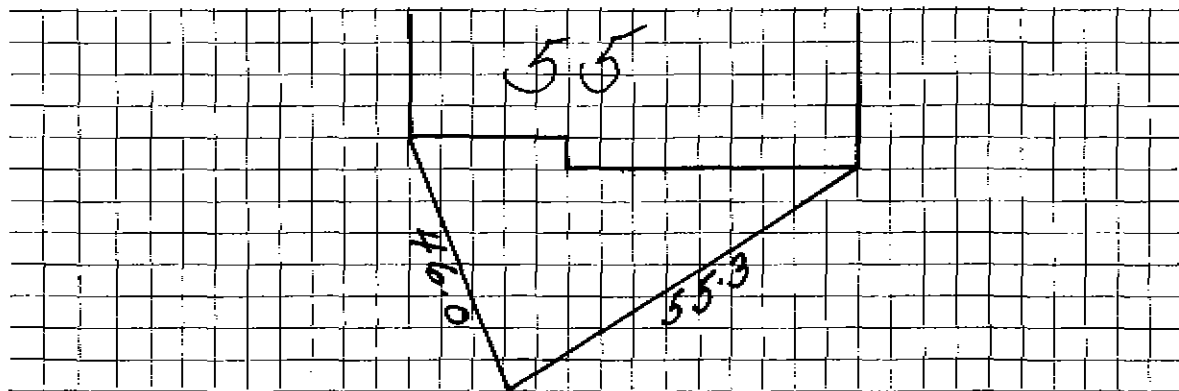

Connection made in _____ Street. Work completed _____ 19

Remarks: