

Name W. Alfred Fletcher

Service No. #1014

Address ~~34~~ Gleason Road

#1880
#1761

Location 59 Gleason Road.

Kind of Pipe

Size

Size of Main

~~Repair - Renewal~~ - New Service

Location

Date	Material	Amount	Total	Date	Location	Amount
1939						
Apr. 24	2 hrs. @ 60¢		1 20	April 24 1939	Deposited	25 00
Jan 4-14 39	42' 3/4" Copper Tubing @ 20¢		8 40			
	1 3/4" S. & W.		3 75			
	Trucking, 2 hrs. @ 75¢		1 50			
	Trench Repairs		4 00			
			<u>18 85</u>			
	Flat Rate:					
	42' @ 50¢	\$21.00				
	Trench Repairs	4.00				
		<u>\$25.00</u>				
	Labor					

Hadley Press, Inc., Lexington

DATE April 24, 1939

TOWN OF LEXINGTON—BOARD OF PUBLIC WORKS

WATER DIVISION

The undersigned applies for a supply of water at No. 59 Gleason Rd St. and hereby agrees to comply with the rules and regulations as now, or at any future time, established by the Board of Selectmen.

Am't. of Estimate \$ 21.00
421 @ 50¢ 21.00
Pat. Levy 4.00


Owner W. Alfred Fletcher

Am't. Paid \$ _____

Address 59 Gleason Rd

Builder W.A. Fletcher

Sketch of Service Here

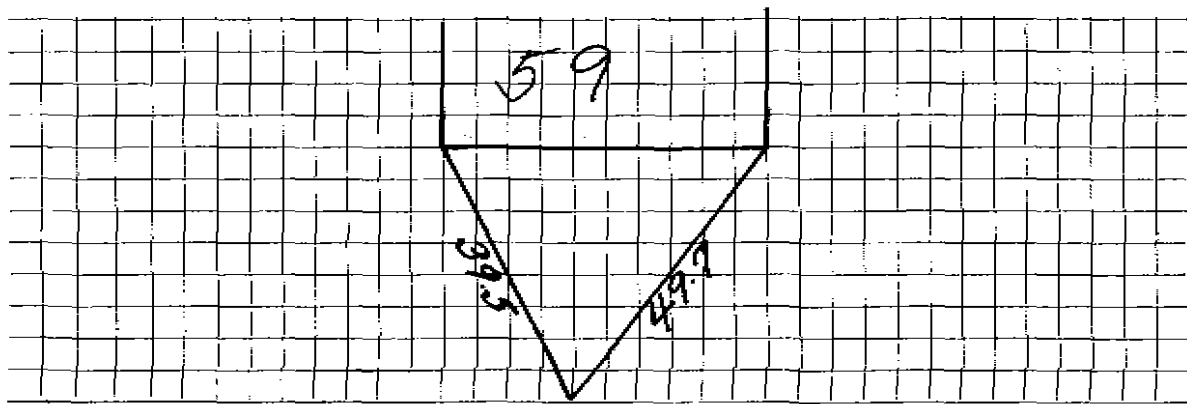

Connection made in _____ Street. Work completed _____ 19

Remarks: