

WATER SERVICE RECORD

Name R. Kimball

Service No. 39

Address 60 Gleason Rd.

Location

~~Repair~~ - Renewal - ~~New Service~~ W.O. 5848


DEC 12 1977

Date	Material	Amount	Total	Date		Amount
10/27/77	Labor	71 85		10-14-77	Deposit	300 00
	10% O.H.	7 18	79 03	12-12-77	Refund	54 47
	36' 3/4 Copper @ .83		29 88			143 53
	1 3/4 Wheel Handle		15 98			
	1/2 Yd. Loam		2 25			
	1 Lb. Seed		39		OUTSIDE	
	1 Hr. Trucking		3 00	10/27/77	Labor	83 83
	2 Hrs. Backhoe @ 6.50		13 00		25' 3/4 Copper @ .83	20 75
			143 53		1 3/4 Curb	15 07
					3 Ton Cold Patch @ 13.50	40 50
					2 lbs. Seed	78
					1 Yd. Loam	4 50
					2 Hrs. Trucking @ 3.00	6 00
					2 Hrs. Backhoe @ 6.50	13 00
					Hot Top 24 x 6	96 00
						280 43

DATE \_\_\_\_\_

TOWN OF LEXINGTON — BOARD OF PUBLIC WORKS  
WATER DIVISION

Sketch of Service Here

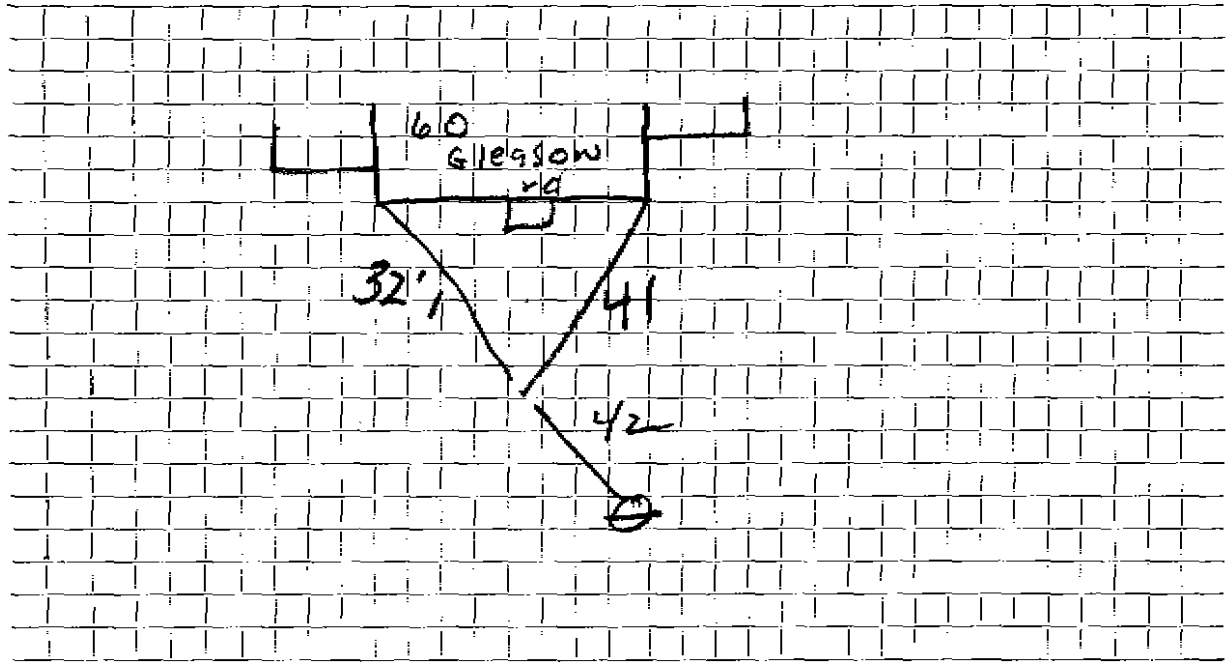

Connection made in ..... Street. Work completed .....

Remarks: .....  
.....  
.....