

Name Walter Cleary

Service No. ~~51~~ 1016

Address 8 Birch Hill Avenue Wakefield, Mass.

457

62 Gleason Road

Location

62 Gleason Road

Kind of Pipe

Size

Size of Main

Repair—Renewal—New Service

Location

| Date | Material | Amount | Total | Date | Amount |
|-----------------|------------------------------|---------|-------|--------------------|--------|
| 1939 | | | | | |
| Sept. 29 | 2 hrs. @ 60¢ | 1 20 | | September 28, 1939 | 16 00 |
| <i>Chas</i> | 10% Overhead | 12 | 1 32 | Sept 29, 1939 | 20 40 |
| <i>10/30/39</i> | 32' 3/4" Copper tubing @ 15¢ | 4 80 | 4 80 | | |
| | 1 3/4" C/x 1/2" I. S. & W. | | 2 10 | | |
| | 1 hr. trucking @ 75¢ | | 75 | | |
| | Trench repairs | | 20 40 | | |
| | | | 29 37 | | |
| | Charge: Flat Rate | 16 00 | | | |
| | Trench repairs | 20 40 | | | |
| | | \$36 40 | | | |
| | Labor | | | | |

Deposited
 Paid
 16 00
 20 40
 \$ 36 40

Hudley Press, Inc., Lexington

DATE April 28 1934

TOWN OF LEXINGTON - BOARD OF PUBLIC WORKS

WATER DIVISION

The undersigned applies for a supply of water at No. 62 Gleason Road ~~St~~ and hereby agrees to comply with the rules and regulations as now, or at any future time, established by the Board of Selectmen.

Am't. of Estimate \$ 16.00


Owner W C Clerey

Am't. Paid \$ _____

Address 2 South Hill Ave

Builder W J Dymally 36 North Hill Ave

Sketch of Service Here

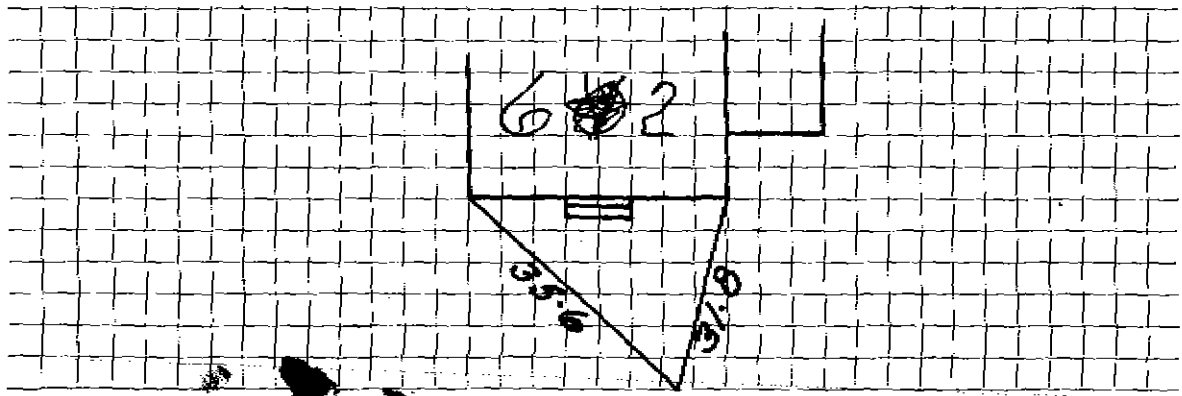

Connection made in _____ Street. Work completed _____ 19

Remarks: