




DATE 12-10-92

TOWN OF LEXINGTON — BOARD OF PUBLIC WORKS  
WATER DIVISION

Sketch of Service Here

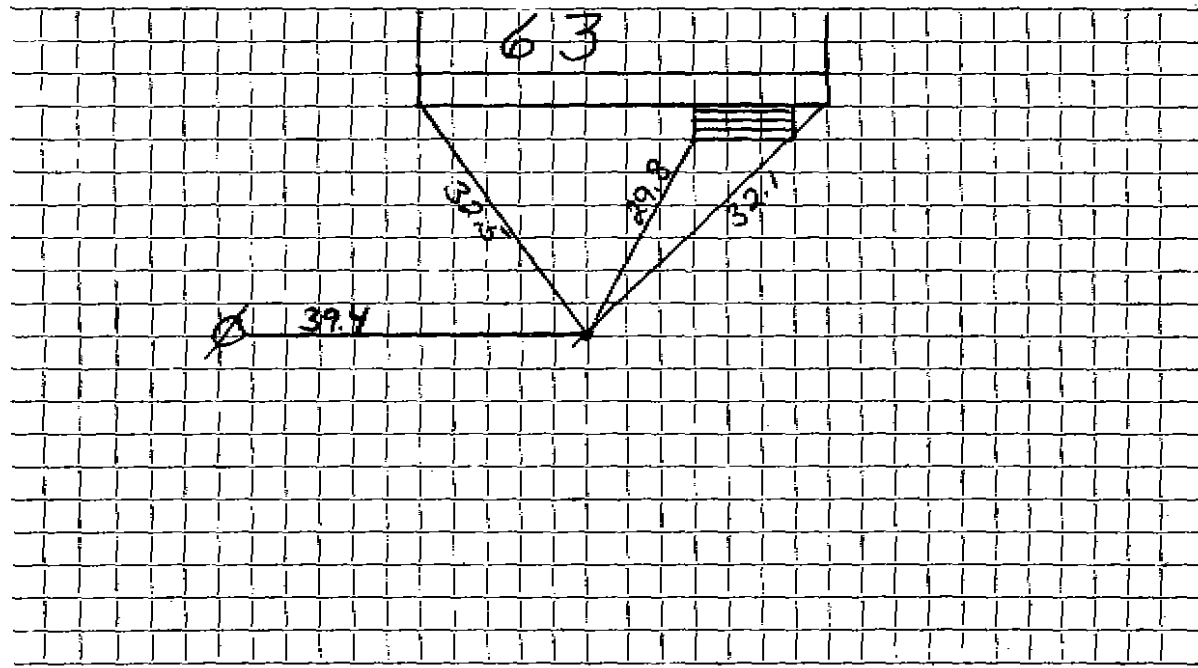

Connection made in 12-10-92 ..... Street.      Work completed .....

Remarks: .....