

Name Victor Lutniciki

Service No.

Address 65 Gleason Road

Lexington, Mass.

Location 65 Gleason Road

Kind of Pipe

Size

Size of Main

~~Repair - Renewal - New Service~~

No charge - damaged to service
caused by installation of sewer service

Location

Date

Material

Amount

Total

Date

Amount

Mar. 31, '18

Labor

2 20

2 20

37' - 3/4" Copper Tubing @.255

9 44

1 - 3/4" C x 1/2" I.W.H. S&W

3 15

Trucking 1 hr, @.75

75

15 54

12' - 3/4" Copper Tubing @.255

3 06

1 - 3/4" C x 3/4" Curb-cock

3 68

1 - 3/4" C adapter

1 50

Trucking 1 hr. @.75

75

8 99

Labor

TOWN OF LEXINGTON - BOARD OF PUBLIC WORKS

WATER DIVISION

The undersigned applies for a supply of water at No..... St. and hereby agrees to comply with the rules and regulations as now, or at any future time, established by the Board of Selectmen.

Am't of Estimate \$.....

Owner


Am't Paid \$.....

Address

Builder

.....

Sketch of Service Here

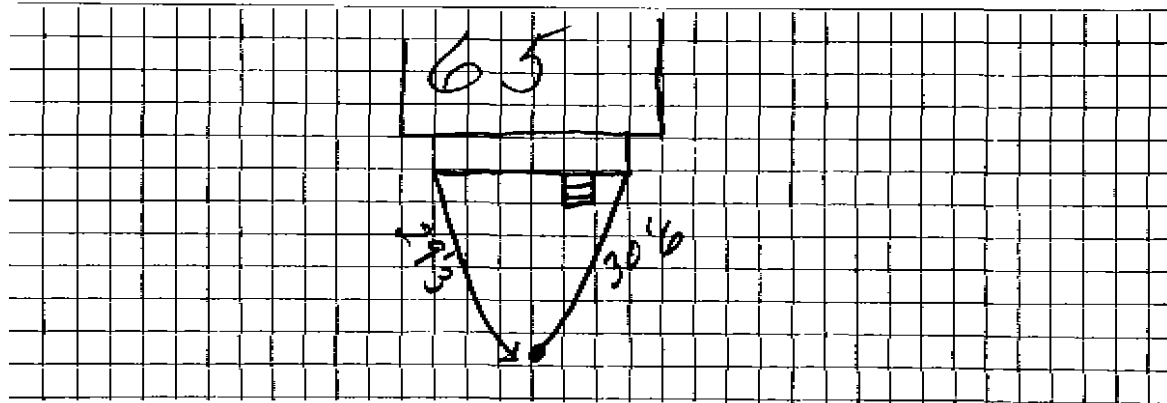

Connection made in Street.

Work completed19

Remarks: