

Name G. Nelson

Service No. ~~30~~ 1019

Address 7 Newcomb St., Arlington, Mass.

67 Gleason Rd.

Location

67 Gleason Road

444

Kind of Pipe

Size

Size of Main

Repair—Renewal—New Service

Location

Date
1940

Material

Amount

Total

Date

Amount

July 19,
com 9/30/40

4 hrs. @ 60	2 40
10% Overhead	24
37' 3/4" Copper tubing @	18
1" 3/4" O.X. 1/2" I. S. & W.	
1 hrs. trucking	
Trench repairs	

2 64
6 66
2 25
75
4 45
<u>16 75</u>

July 19, 1940 Deposited
October 2, 1940 Returned

22 00
<u>5 25</u>
16 75

Labor

Hadley Press, Inc., Lexington

DATE July 18, 1940

TOWN OF LEXINGTON—BOARD OF PUBLIC WORKS
WATER DIVISION

The undersigned applies for a supply of water at No. 67 Gleason Road St. and hereby agrees to comply with the rules and regulations as now, or at any future time, established by the Board of Selectmen.

Am't. of Estimate \$ _____

Owner Lawrence McLean


Am't. Paid \$ _____

Address 7 Gleason St.

Builder J. S.

July 18, 1940

Sketch of Service Here

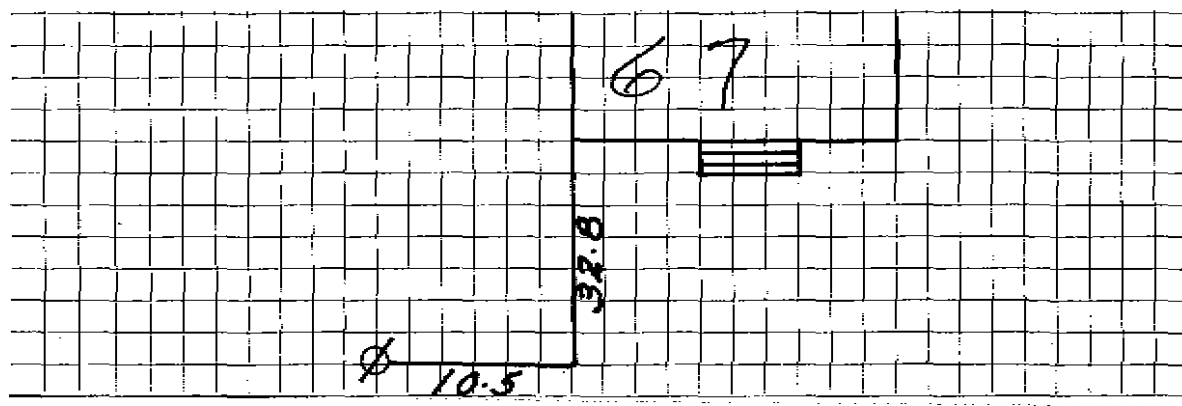

Connection made in _____ Street.

Work completed _____ 19

Remarks: