

**WATER SERVICE RECORD**

Name *Ann Menashi*

Service No.

Address *68 Gleason Road*

Location


Repair—Renewal—New Service

Date	Material	Amount	Total	Date	Material	Amount
	<i>Bruce McKee #4977</i>					
<i>7/7/87</i>	<i>40' 3/4" Copper</i>					
	<i>1 3/4 Ball Valve</i>					
					<i>OUTSIDE</i>	
				<i>7/14/87</i>	<i>29' 3/4" Copper</i>	
					<i>1 3/4 Curb Stop</i>	
					<i>1 3/4 Compression 3 pt. union</i>	
					<i>1 3/4 Corporation Adaptor</i>	
					<i>1 Curb Box &amp; Rod</i>	
					<i>27 yds. gravel</i>	

DATE \_\_\_\_\_

TOWN OF LEXINGTON — BOARD OF PUBLIC WORKS  
**WATER DIVISION**

Sketch of Service Here

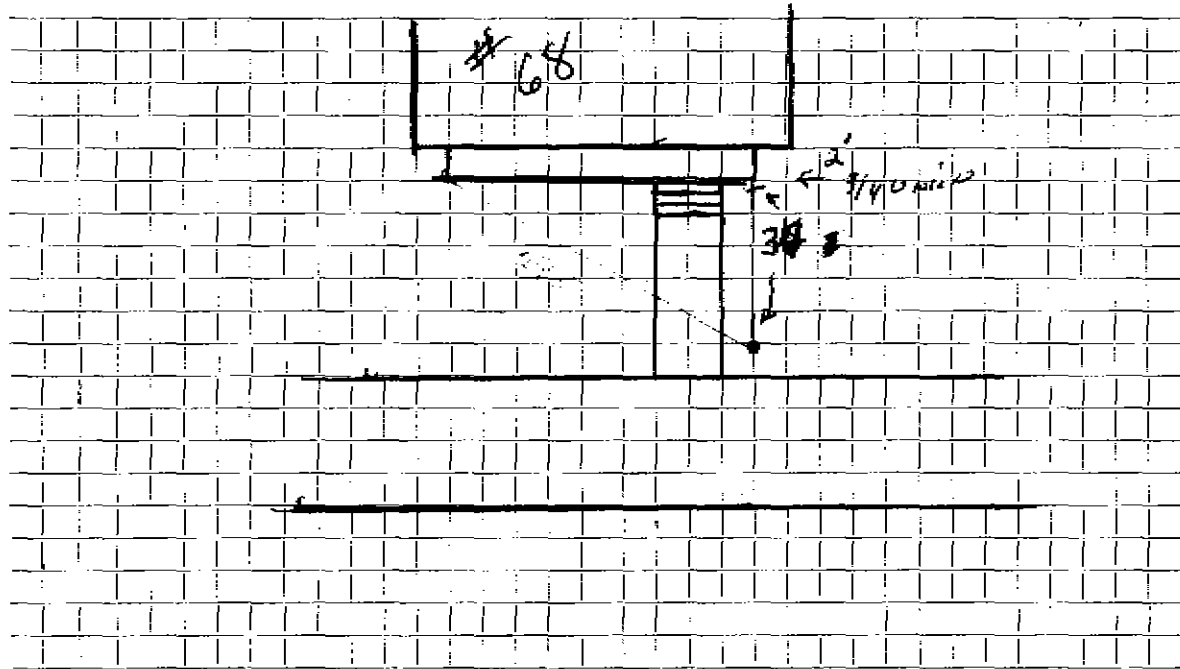

Connection made in ..... Street. Work completed .....

Remarks: .....

.....  
.....