

Name Paul B. West  
 Address 70 Gleason Road  
 Lexington, Mass

Service No. 232 # <sup>3992</sup> 2/2

Locatic 70 Gleason Road

Kind of Pipe Size Size of Main

~~Repair~~ ~~Renewal~~ ~~New Service~~ Com. 11-6-50

Location

Date	Material	Amount	Total	Date	Amount
Sept. 6, '50	Labor	1 50	1 50	Aug 7 '50	2 00
	10% Overhead		15		1 50
	39' - 3/4" Copper Tubing @.275	10 73			16 00
	1 - 3/4" C x 1/2" I.W.E. S&W	3 29		Sept. 6, '50	Labor
	Trucking 1 hr. @.75	75	16 42		1 50
				24' - 3/4" Copper Tubing @.275	6 60
				1 - 3/4" C Corp-cock	3 15
				1 - 3/4" C x 3/4" C Corp-cock	3 85
				1 - Box & Rod	3 35
				1 - 1/2" Offset Tail Piece	42
				1 - 1/2" Straight Tail Piece	42
				Trucking 1 hr. @.75	75
					20 04

3/14/60 RENEWED  
 40' OF 1" COPPER  
 5' DEEP

Labor

Hadley Press, Inc., Lexington

DATE \_\_\_\_\_

# TOWN OF LEXINGTON—BOARD OF PUBLIC WORKS

## WATER DIVISION

The undersigned applies for a supply of water at No. \_\_\_\_\_ St. and hereby agrees to comply with the rules and regulations as now, or at any future time, established by the Board of Selectmen.

Am't. of Estimate \$ \_\_\_\_\_


Owner \_\_\_\_\_

Am't. Paid \$ \_\_\_\_\_

Address \_\_\_\_\_

Builder \_\_\_\_\_

Sketch of Service Here

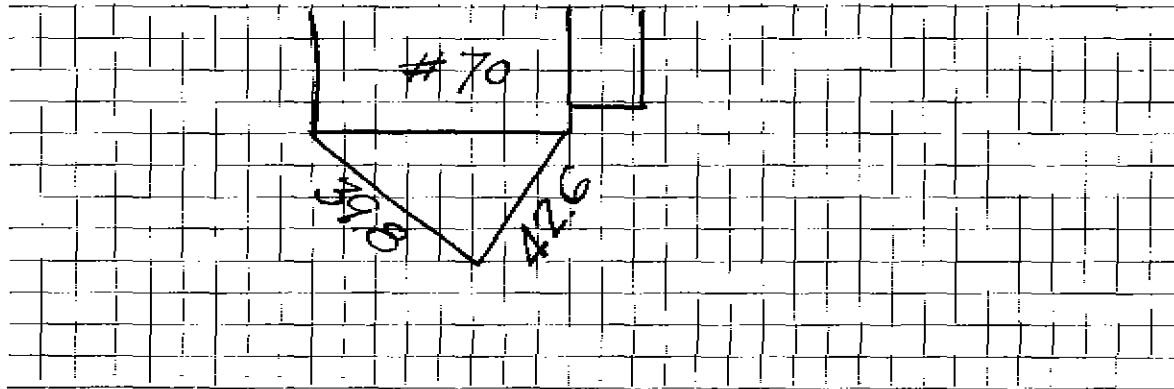

Connection made in \_\_\_\_\_ Street.

Work completed \_\_\_\_\_ 19\_\_

Remarks: