


DATE _____

TOWN OF LEXINGTON — BOARD OF PUBLIC WORKS

WATER DIVISION

Sketch of Service Here

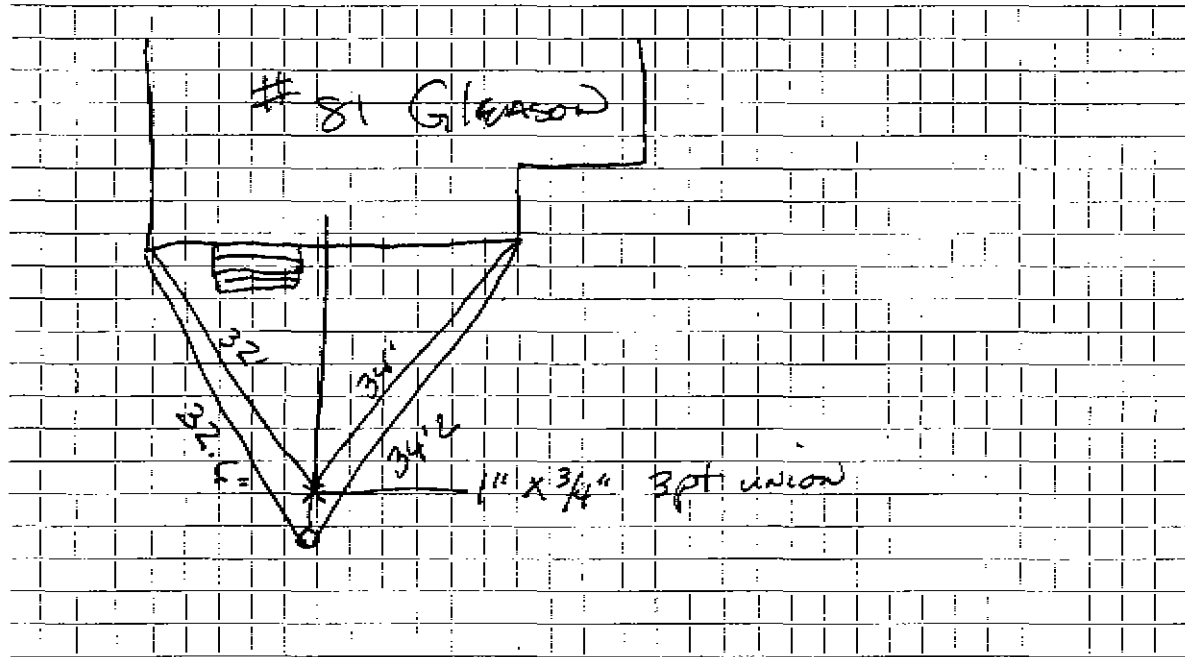

Connection made in Street. Work completed

Remarks:

.....

.....

Name Frank A. Fulton

Service No. ~~58~~ 1021

Address 120 Robbins Street, Waltham

81 Gleason Road

Location ~~120~~ #81-Gleason Road

Kind of Pipe

Size

Size of Main

~~Reports removed~~ - New Service

Location

Date	Material	Amount	Total	Date	Amount
------	----------	--------	-------	------	--------

1-7-12-28
for
15.00

32' 1" C.L. Pipe @ .27 8 64

1 1" L.L. Coupling 25

2 1" Br. Sp. Nip. @ .25 50

2 1" L.L. Ells. @ .30 60

9 69

2 Hrs. Labor @ .60 1 20

15% Overhead 18

Trucking 75

11 82

3 15

15 00

May 25 1928 - Cash

15 00

Labor

Hudley Press, Inc., Lexington

DATE May 23, 1928

TOWN OF LEXINGTON—BOARD OF PUBLIC WORKS
WATER DIVISION

The undersigned applies for a supply of water at No. #81 Gleason Road St. and hereby agrees to comply with the rules and regulations as now, or at any future time, established by the Board of Selectmen.

Am't. of Estimate \$ _____

Owner Frank A. Fulton


Am't. Paid \$ 1.00

Address 120 Robbins St

Builder _____

Waltham

Sketch of Service Here

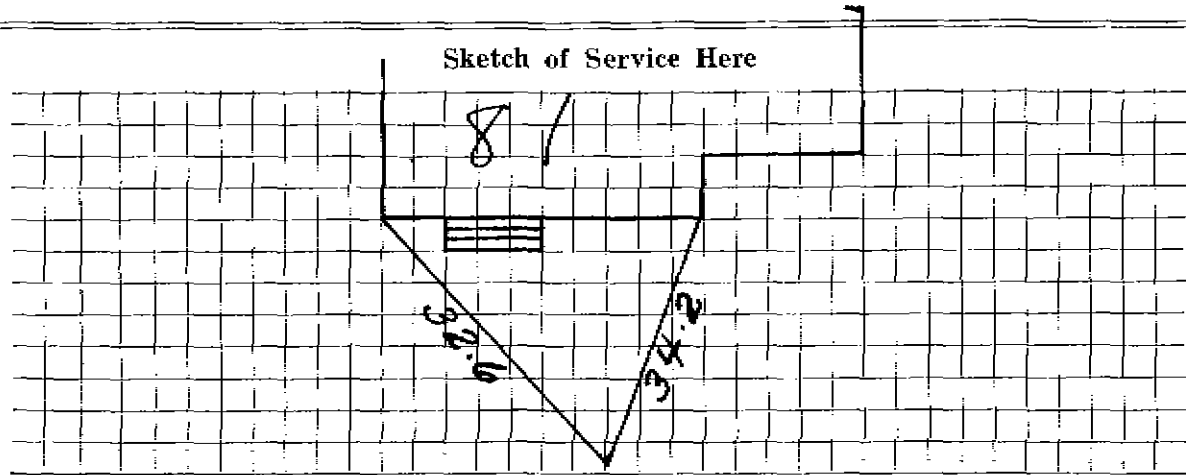

Connection made in _____ Street.

Work completed _____ 19

Remarks: