

WATER SERVICE RECORD

Name William H. Sullivan

Service No. 41

5219

Address 82 Gleason Road

Location Lexington,

~~Repair~~ ~~XXXXXX~~ New Service

COM. 4-28-52

Date	Material	Amount	Total	Date	Amount
3/28/52	Labor	1 49	1 49	3-26-52	25 00
	10% overhead		15	4-24-52	4 86
	40' - 3/4" copper tubing @ .3439	13 75			20 14
	1 - 3/4" C x 1/2" I.W.H. stop & waste	4 00			
	1 hr. trucking		75	3/28/52	1 49
			20 14	28' - 3/4" copper tubing @ .3439	9 28
				1 - 3/4" C. corp-cock	4 33
				1 - 3/4" C x 3/4" C. curb-cock	4 67
				1 box and rod	4 52
				1 - 1/2" offset tail piece	50
				1 - 1/2" straight tail piece	50
				1 hr. trucking	75
					26 04


Deposited
Repaid & applied
to S.H.C. # 33
NON CHARGE

DATE _____

TOWN OF LEXINGTON — BOARD OF PUBLIC WORKS

WATER DIVISION

Sketch of Service Here

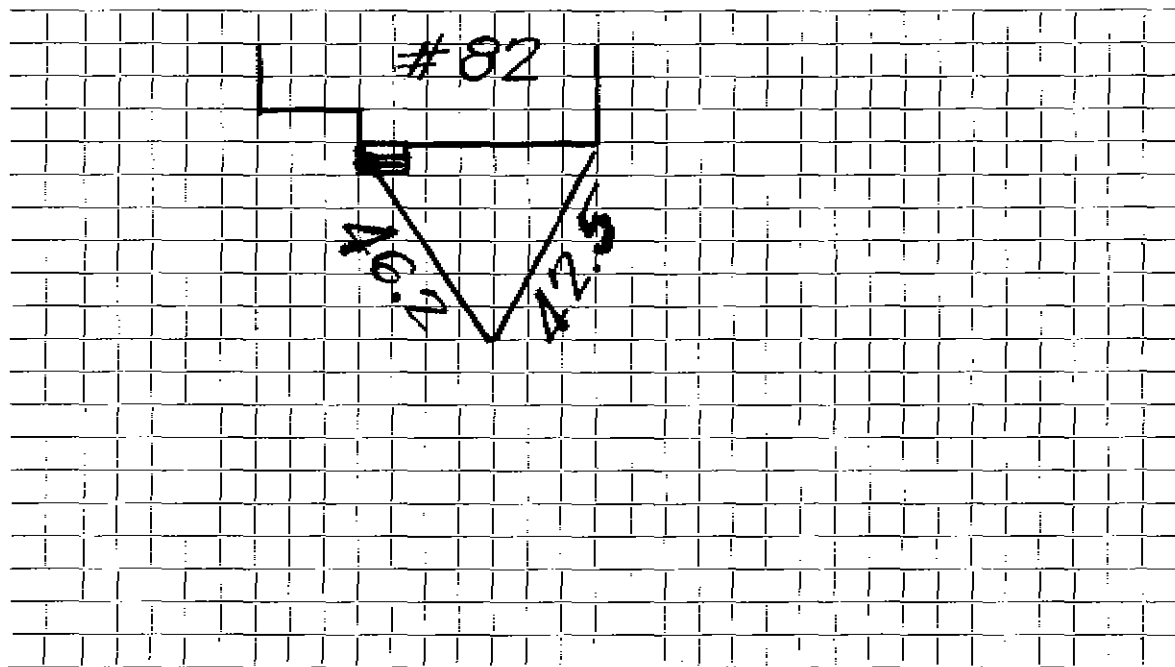

Connection made in Street. Work completed

Remarks:

.....

.....