

Name Z. E. Cliff

Service No. ~~1022~~
4330

Address 164 Bedford St., Lexington

84 Gleason Rd.

Location Lots #42, #43, Gleason Road
#84 (2nd on left from Simonds Road)

Kind of Pipe

Size

Size of Main

~~Repair - Renewal~~ - New Service

Location

Date	Material	Amount	Total	Date	Amount
5/5/33 <i>Com. 1928 6-28-33</i>	40' $\frac{3}{4}$ " Copper Pipe @.12	\$4 80		<i>June 14 1933 - Cash</i>	19 20
	1 S & W	2 75			
	Trucking	75	\$8 30		
	7 Hrs. Labor @.55	3 85			
	2 " " @.60	1 20	5 05		
	15% Overhead		76		
			\$14.11		
	<u>COST</u>				
	<u>CHARGE</u>				
	ESTIMATED COST	\$19 20	\$19 20		
	Labor				

Hidley & Sons, Inc., Lexington

1st on left

DATE June 14, 1933

TOWN OF LEXINGTON—BOARD OF PUBLIC WORKS

WATER DIVISION

The undersigned applies for a supply of water at No. Lots 42 & 43, Gleason Rd. St. and hereby agrees to comply with the rules and regulations as now, or at any future time, established by the Board of Selectmen.

Am't. of Estimate \$ 19²⁰


Owner R. Z. E. Cliff

Am't. Paid \$ 19²⁰

Address 164 Bedford St.
Lexington

Builder Roy MacLellan
45 South Ave. Sum.

Sketch of Service Here

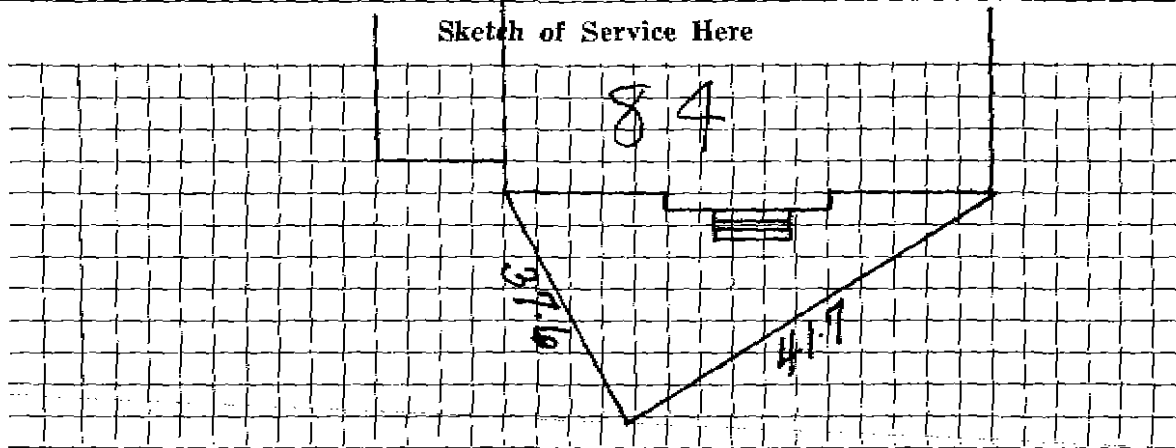

Connection made in _____ Street.

Work completed _____ 19

Remarks: