

Name Innis and McLennan

Service No. ~~3356~~ 1023

Address Boston Road, Billerica, Mass.
85 Gleason Road

Location 85 Gleason Road

Kind of Pipe

Size

Size of Main

Repair—Renewal—New Service

Location

Date
1939

Material

Amount

Total

Date

Amount

July 14,

2 hrs. @ 60¢

1 20

July 12, 1939 Deposited

22 00

on 9/11/39

33' 3/4" Copper Tubing @ 20¢

9 60

1 3/4" C.x¹/₂" I S. & W.

3 75

2 hrs. trucking @ 75¢

1 50

Trench repairs

4 45

\$ 20 50

Charge Flat Rate: \$22.00.

Labor

DATE

July 11 1929

TOWN OF LEXINGTON - BOARD OF PUBLIC WORKS

WATER DIVISION

The undersigned applies for a supply of water at No. 85 Gesson Rd. St. and hereby agrees to comply with the rules and regulations as now, or at any future time, established by the Board of Selectmen.

Am't. of Estimate \$ 17.00

Owner

Ernie + M^{rs} Lerman

Am't. Paid \$ _____


Address

Boston Road

Builder _____

Billerica

Sketch of Service Here

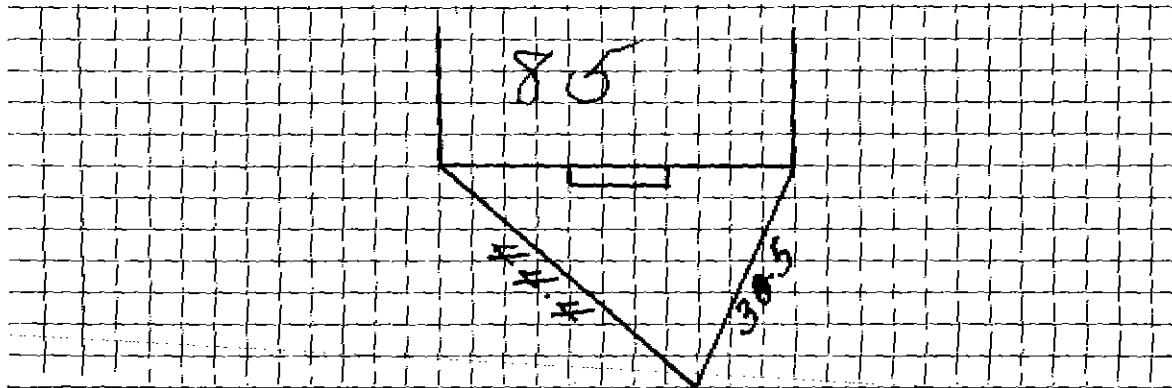

Connection made in _____ Street.

Work completed _____ 19

Remarks: