

Name Z. E. Cliff

Service No. # 1024

Address 309 High Street, Medford  
86 Gleason Rd.

#86 Gleason Rd. (copy left from...)

Location Lot #40, 41, Gleason Road

Kind of Pipe Size Size of Main

Repairs-Renewal-New Service

Location

Date	Material	Amount	Total	Date	Amount
5/5/33	40' 3/4" Copper Pipe @.12	4 80			
1	S & W	2 75			
	Trucking	75	\$8 30		
7	Hrs. Labor @.55	3 85			
2	" " @.60	1 20	5 05		
	15% Overhead		76		
	<b>COST</b>		\$14.17		
	<b>CHARGE</b>				
40'	@ .60 is \$24.00, but he deposited only \$19.20, so say,		\$19.20		
	<b>Labor</b>				

May 2 1933-Cash

19 20

Radio Press, Inc., Lexington

25' setback

DATE March 17, 1933

TOWN OF LEXINGTON—BOARD OF PUBLIC WORKS  
WATER DIVISION

The undersigned applies for a supply of water at No. 407 1/2 Gleason Rd. St. and hereby agrees to comply with the rules and regulations as now, or at any future time, established by the Board of Selectmen.

Am't. of Estimate \$ 19<sup>20</sup>

Owner

J. E. Cluff

Am't. Paid \$ 19<sup>20</sup>

Address


309 High St

Medford

Builder

Roy MacLaggan  
45 Boston Ave. Somerville

Sketch of Service Here

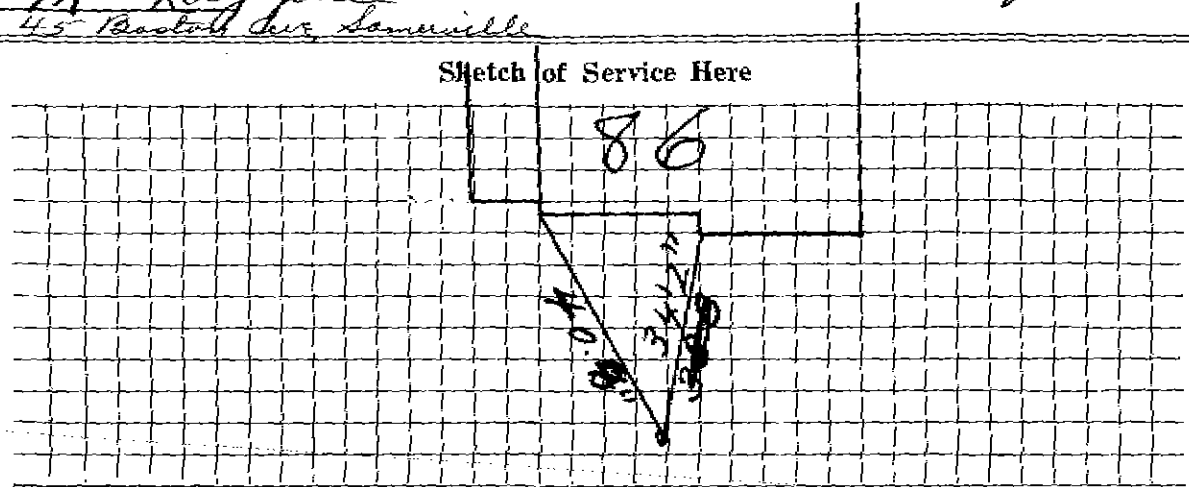

Connection made in \_\_\_\_\_ Street.

Work completed \_\_\_\_\_ 19

Remarks: