

Name

Address 87 Gleason Rd.

Service No. 1025
334

Location 87 Gleason Rd.

Kind of Pipe

Size

Size of Main

Repair—Renewal—New Service

Location

Date	Material	Amount	Total	Date	Amount
	Labor				

DATE _____

TOWN OF LEXINGTON—BOARD OF PUBLIC WORKS

WATER DIVISION

The undersigned applies for a supply of water at No. _____ St. and hereby agrees to comply with the rules and regulations as now, or at any future time, established by the Board of Selectmen.

Am't. of Estimate \$ _____

Owner

C. L. Weld


Am't. Paid \$ _____

Address

87 Gleason Rd.

Builder _____

Sketch of Service Here

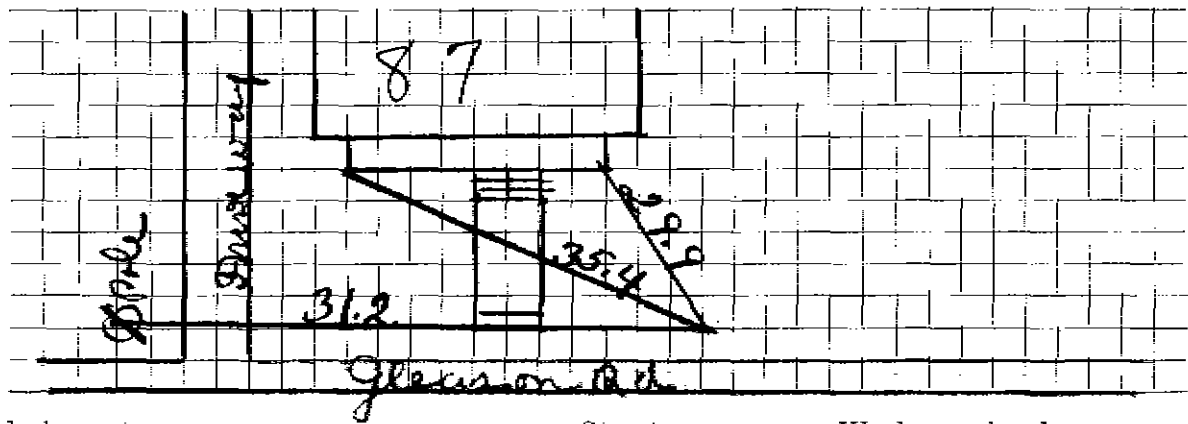

Connection made in _____

Street.

Work completed _____

19 _____

Remarks: