

Name George Selfridge
 Address 9 Gleason Road

Service No. ~~184~~ 3422
 #4057

Location 9 Gleason Road

Kind of Pipe

Size

Size of Main

~~Repair~~—~~Renewal~~—New Service

Com. 12/16/47

Location

Date	Material	Amount	Total	Date	Location	Amount
12/16/47	Labor	6 85	6 85	12/10/47	Deposited	35 00
	10% Overhead		69	12/31/47	Refunded	5 26
	30' $\frac{3}{4}$ " C. Tubing @ .26		7 30			<hr/> 29 74
	1 $\frac{3}{4}$ " Cx $\frac{1}{2}$ " I.W.H S&W		3 15		Non-Charge	
	1 $\frac{1}{2}$ hr. Hired Shovel @ 7.00	7 00	10 50	12/16/47	Labor	16 22
	1 hr. Trucking		75		17' $\frac{3}{4}$ " C. Tubing @ .26	4 42
			<hr/> 29 74		1 $\frac{3}{4}$ " C. Corp. Cock	3 00
					1 $\frac{3}{4}$ " Cx $\frac{1}{4}$ " C. Curb-cock	3 68
					1 Box and Rod	4 26
					1 $\frac{1}{2}$ " Str. Tailpeice	30
					1 $\frac{1}{2}$ " Offset Tailpeice	30
					1 hr. Trucking	75
	Labor					<hr/> 32 93

TOWN OF LEXINGTON – BOARD OF PUBLIC WORKS
WATER DIVISION

The undersigned applies for a supply of water at No. St. and hereby agrees to comply with the rules and regulations as now, or at any future time, established by the Board of Selectmen.

Am't of Estimate \$.....


Owner

Am't Paid \$.....

Address

Builder

Sketch of Service Here

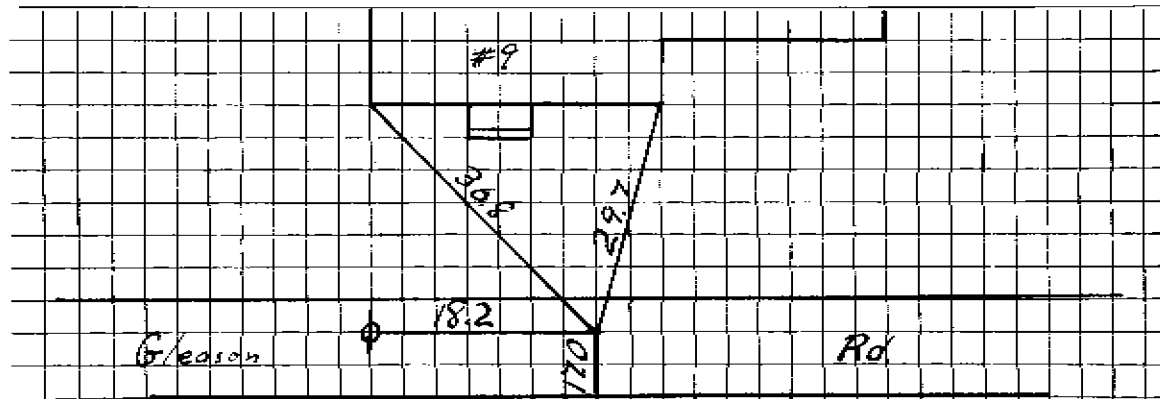

Connection made in Street.

Work completed19

Remarks: