

Name Innis & McLennan

Service No. ~~48~~ 1026

Address Billerica, Massachusetts

# 2582

90 Gleason Road

Location 90 Gleason Road

Kind of Pipe

Size

Size of Main

Repair—Renewal—New Service

Location

Date  
1939

Material

Amount

Total

Date

Amount

Sept. 21,  
Con  
10/30/39

lbr. @ 60¢

60

1 25

September 18, 1939 Deposited

30.00

1 @ 65¢

65

January 2, 1940 Paid

3.71

10% Overhead

13

33.71

41' 3/4" Copper tubing @ 15¢

6 15

1 3/4" C.x 1/2" S.& W.

2 10

1 hr. trucking

75

Trench repairs

23 33

33 71

11/2/39  
11/17/39

Labor

DATE Sept 16. 1939

TOWN OF LEXINGTON—BOARD OF PUBLIC WORKS  
**WATER DIVISION**

The undersigned applies for a supply of water at No. 90 Gleason Rd. St. and hereby agrees to comply with the rules and regulations as now, or at any future time, established by the Board of Selectmen.

Am't. of Estimate \$ 30<sup>00</sup> / 100


Owner Josiah M. Lennox

Am't. Paid \$ \_\_\_\_\_

Address Belleua Mass

Builder \_\_\_\_\_

Sketch of Service Here

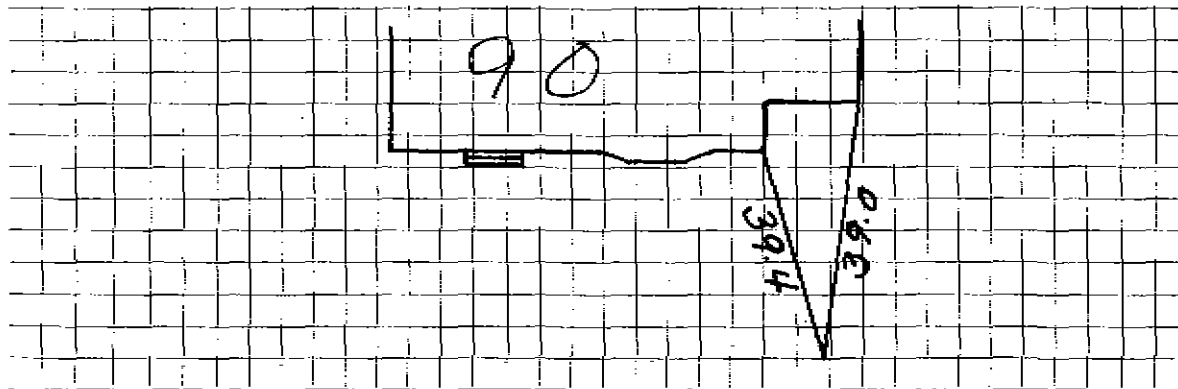

Connection made in \_\_\_\_\_ Street. Work completed \_\_\_\_\_ 19

Remarks: