

Name Z. E. Cliff
 Address 309 High St., Medford
 91 Gleason Rd.

Service No. # 1027

Location Lots 9, 10, Gleason Road
 #91 Gleason Rd

Kind of Pipe Size Size of Main

~~Repair~~ ~~Renewal~~ - New Service

Location

Date	Material	Amount	Total	Date	Amount
5/5/33	34' 1/2" Copper Pipe @.12	\$4 08			
19.50 6-20-33	1 S & W Trucking	2 75	7 58	March 17 1933 - Cash	19 20
	7 Hrs. Labor @.55	3 85			
	2 " " @.60	1 20	5 05		
	15% Overhead		76		
	<u>COST</u>		\$12 70		
	<u>CHARGE</u>	40' @.60 is \$24.00, but he deposited only \$19.20, so say	\$19 20		
	Labor				

Hadley Press, Inc., Lexington

DATE May 2, 1933

TOWN OF LEXINGTON—BOARD OF PUBLIC WORKS

WATER DIVISION

The undersigned ^{Lt.} applies for a supply of water at No. 9710, Glenora Road St. and hereby agrees to comply with the rules and regulations as now, or at any future time, established by the Board of Selectmen.

Am't. of Estimate \$ 19²⁰


Owner J. E. Leiff

Am't. Paid \$ 19²⁰

Address 309 High St.
Medford

Builder _____

Sketch of Service Here

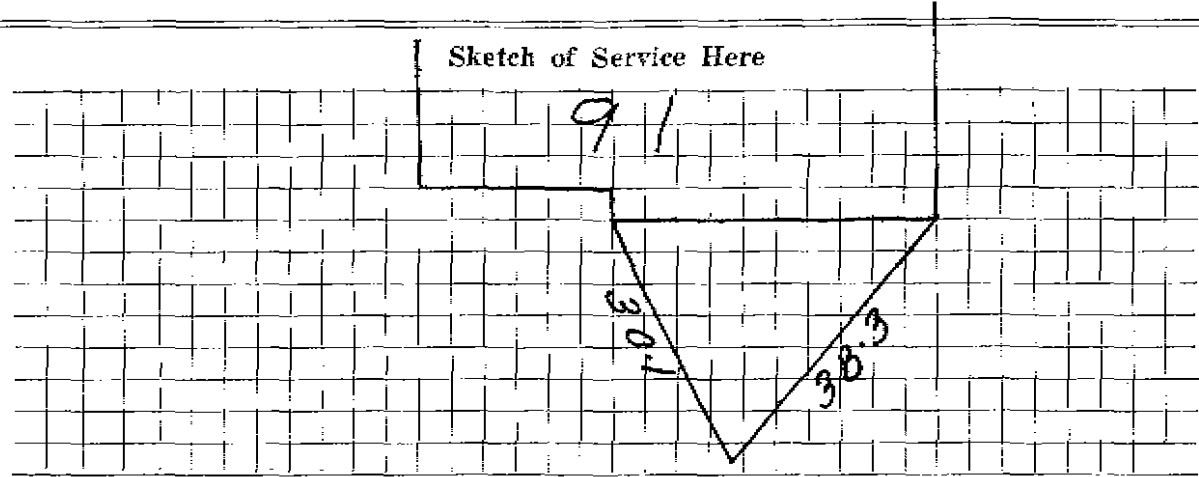

Connection made in _____ Street. Work completed _____ 19

Remarks: